

**SURVEY & REMONUMENTATION**

**JAN 14 1998**

**SECTION**

**LAND CORNER RECORDATION CERTIFICATE**  
**Filing Requirement of Act 74, Mich. P.A. 1970**

Approved By Delta County  
 Land Survey Remonumentation  
 Peer Group Under Act 345 Of  
 P.A. Of 1990 On 12/18, 1997  
*Phyllis Schmeling*  
 Acting Chairman

For corners in

DELTA (County)	Located In:	Corner Code #
1. Public Land Survey	T 41 N R 22 W	E-01 & E-02
	T 42 N R 22 W	E-13
	T _____ R _____	_____
	T _____ R _____	_____
2. Property Controlling in Section	S _____ T _____ R _____	_____
	S _____ T _____ R _____	_____
3. Miscellaneous Property in Sec.	S _____ T _____ R _____	_____
	S _____ T _____ R _____	_____

*Dec 19 1997*  
*9:00 AM*  
*278*

Register of Deeds Stamp & File Number

4. Lot No. \_\_\_\_\_, Recorded Plat \_\_\_\_\_  
 5. Private Claims \_\_\_\_\_  
 E-01 [NW COR S.4-SAME CORNER AS E-13 ABOVE] E-02 [W1/4 S. 4]

	A	B	C	D	E	F	G	H	I	J	K	L	M
2	6			5	4	3	2	1					
3													
4	7	8	9	10	11	12							
5													
6	18	17	16	15	14	13							
7													
8	19	20	21	22	23	24							
9													
10	30	29	28	27	26	25							
11													
12	31	32	33	34	35	36							
13													

I, M.P. DAVIS, in a field survey on JUNE 29, 19 97, do hereby certify that under requirements of P.A. 74, Michigan P.A. of 1970, the corner points mentioned in lines 1 and 2 above were in conformance with regulations and rules therefore as required in the current manual of survey instructions of the United States Department of the Interior, Bureau of Land Management or by a decree of a Court of Law and/or that the corner points mentioned in lines 3, 4 and 5 above were in conformance with the rules of the Michigan Board of Land Surveyors or by a Decree of a Court of Law; established, re-established, monumented, re-monumented, recovered, found as expressed below:


**NOTE: Not more than 4 corners, all in the same town and range, may be recorded on this certificate.**

**A. Description of original monument and accessories and/or subsequent restoration:**

- E-01 [NW COR SEC 4] JOHN BURT, DS-1845-WOOD POST-CEDAR 08"-N64°E-42 LINKS)(FIR 12"-N12°W-40 LINKS)  
 A.MERRYWEATHER, DS - 1847 - WOOD POST - (BALSAM 08"-S31°E-22 LINKS)(BIRCH 08"-S24°W-11 LINKS)  
 D.A.BROTHERTON-1910-ID COR FROM STAKE IN PLACE & BT STAKES NW & SE 33'-SET IRON BOLT FROM WHICH COR FENCE POST S88°W-28.8'  
 M.DAVIS-1972-FOUND IN PLACE IRON PIN & REMAINS OF WOOD POST-PP N60°W-30.5' TP N32°E-50.0' MAPLE 18"-S31°E-59.7' REC'D L.1 PG 339
- E-02 [W1/4 COR SEC 4] A.MERRYWEATHER, DS - 1847 - WOOD POST - (SUGAR 18"-N38°E-20 LINKS)(BALSAM 08"-S55°W-20 LINKS)  
 C.E.BROTHERTON-1884-SURVEY FOR TOWNSHIP ROADS-ID CORNER POSITION FROM ORIGINALS (NO NEW BT'S NOTED)  
 D.A.BROTHERTON-1910-ID CORNER POSITION BY IRON WAGON AXEL IN PLACE (TELE POLE S63°E-37.3')  
 M.S.McNABB-1927-IRON STAKE IN PLACE-ID FROM SUPV PLAT OF PERKINS (PP N58°W-44.3' SW COR HOUSE-S18°E-73.5' IRON STAKE SOUTH 33.0'  
 M.DAVIS-1972-SET RR SPIKE FROM RETRACEMENT OF SUPV PLAT OF PERKINS-1/2" IRON SOUTH 33' NE COR HOUSE S38°E-83.1 SW COR OF HOUSE N53°E 126.7' C/L ELM 15" S15°W-50.9'

**B. Description of corner evidence found and/or method applied in restoring or reestablishing corner:**

- E-01 [NW COR SEC 4] FOUND IN PLACE MONUMENT AS RECOVERED BY MYSELF IN 1972 & REC'D IN LIBER 1 OF LCR'S ON PG 399. 1972 WIT'S HAVE BEEN REMOVED AND/OR DESTROYED. ID CORNER MONUMENT BY RETRACEMENT OF MY 1972 SURVEY. ACCEPTED EXISTING MONUMENT AS BEING THE BEST AVAILABLE EVIDENCE AS TO THE POSITION OF THE ORIGINAL CORNER.
- E-02 [W1/4 COR SEC 4] FOUND IN PLACE TRACK SPIKE AS SET BY MYSELF IN 1972. ID COR MONUMENT BY WIT'S NOTED IN 1972 LCR. ACCEPTED EXISTING MONUMENT AS BEING THE BEST AVAILABLE EVIDENCE AS TO THE LOCATION OF THE POSITION OF THE ORIGINAL CORNER.

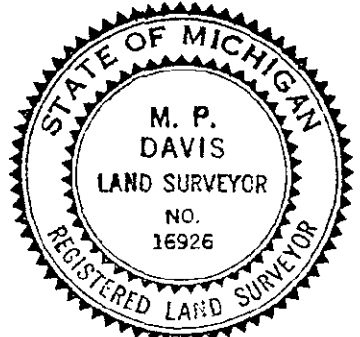

**C. Description of monument for corner and accessories established to perpetuate locating the position of the corner:**

- E-01 SET OVER EXISTING MON A 5/8" X 18" REBAR WITH A 3 1/4" ALUM CAP STAMPED TO ID THE CORNER POSITION & RAISED TO GRADE W/A MON BOX.  
 MAPLE 10" POWER POLE MAPLE 24" ELM 09" SURVEY MONUMENT SIGN POST  
 N54°E N55°W S38°E S48°W WEST  
 44.92' 31.01' 49.48' 47.12' 24.37' (TO FACE)
- E-02 REPLACED EXISTING MON W/A 5/8" X 18" REBAR W/A 3 1/4" ALUM CAP STAMPED TO ID THE CORNER POSITION & RAISED TO GRADE W/A MON BOX  
 MAPLE 36" MAPLE 14" SE CORNER CONC HDWALL SURVEY MONUMENT SIGN POST  
 40°E S50°E S65°W N28°W  
 44.92' 58.15' 45.17' 50.95' (TO FACE)

NOTE: BEARINGS TO REFERENCE OBJECTS ARE MAGNETIC & DISTANCES ARE TO A NAIL W/A REFERENCE TAG UNLESS OTHERWISE NOTED.

Signed by M.P. Davis Date 1/12/97  
 Surveyor's Michigan License No. 16926