

SURVEY & REMONUMENTATION

NOV 25 1998

SECTION

LAND CORNER RECORDATION CERTIFICATE
Filing Requirement of Act 74, Mich. P.A. 1970

Approved By Delta County
Land Survey Remonumentation
Peer Group Under Act 345 Of
P.A. Of 1990 On Sept 25, 1998
Robert Schmelting
Acting Chairman

For corners in
DELTA
(County)

Located In: Corner Code #

1. Public Land Survey	T 41 N R 22 W	E-04 & E-06
	T R	
	T R	
	T R	
2. Property Controlling in Section	S T R	
	S T R	
3. Miscellaneous Property in Sec.	S T R	
	S T R	

Recorded SEP 28 1998
at 9:00 o'clock AM
Liber 9 Page 96
William C. Thorne
Delta County, MI Reg. of Deeds
Register of Deeds Stamp & File Number

4. Lot No. _____, Recorded Plat _____
5. Private Claims
E-04 [W1/4 COR S.9] E-06 [W1/4 S.16]

	A	B	C	D	E	F	G	H	I	J	K	L	M
2	6	5	4	3	2	1							
3													
4	7	8	9	10	11	12							
5													
6	18	17	16	15	14	13							
7													
8	19	20	21	22	23	24							
9													
10	30	29	28	27	26	25							
11													
12	31	32	33	34	35	36							
13													

I, M.P. DAVIS, in a field survey on JULY 1, 19 98, do hereby certify that under requirements of P.A. 74, Michigan P.A. of 1970, the corner points mentioned in lines 1 and 2 above were in conformance with regulations and rules therefore as required in the current manual of survey instructions of the United States Department of the Interior, Bureau of Land Management or by a decree of a Court of Law and/or that the corner points mentioned in lines 3, 4 and 5 above were in conformance with the rules of the Michigan Board of Land Surveyors or by a Decree of a Court of Law; established, re-established, monumented, re-monumented, recovered, found as expressed below:


NOTE: Not more than 4 corners, all in the same town and range, may be recorded on this certificate.

A. Description of original monument and accessories and/or subsequent restoration:

- E-04 [W1/4 COR SEC 9] A.MERRYWEATHER, DS-1845-WOOD POST-(HEMLOCK 12"-S10°W-15 LINKS)(CEDAR 14"-N40°E-09 LINKS) D.A.BROTHERTON-1895-ID CORNER STAKE BY "GLO" CEDAR BT NE-RESET NEW STAKE-NO NEW WIT'S NOTED. M.S.McNABB-1925-ID BY STAKE IN PLACE-SET BY STAKES NW & SE 33' & ELM 6" S6°E 29.25' T.OBRIEN-1979-SET IRON IN C/L OF HWY. & McNABB'S DISTANCE EAST OF THE C1/4 COR SEC 8-BALSAM 6" S26°E 36.7' BALSAM 6" S64°W 43.5' REC'D LIBER 2 PG 298
- E-06 [W1/4 COR SEC 16] A.MERRYWEATHER, DS - 1847 - WOOD POST - (HEMLOCK 09"-N72°W-18 LINKS)(Y.BIRCH 32"-S58°E-12 LINKS) M.S.McNABB-1922-ID FROM ORIGINALS-SET NEW STAKE-PINE STUB 32" S58°E 8.0' & SPRUCE 10" N72°W 17.75'

B. Description of corner evidence found and/or method applied in restoring or reestablishing corner:

- E-04 [W1/4 COR SEC 9] FOUND IN PLACE 1/2" IRON PIN, BENT & IN POOR CONDITION WITH SURVEY CAP GONE. ID EXISTING MON BY BALSAM STUMPS WHICH FIT BARING & DISTANCE AS NOTED BY T.O'RIEN. ACCEPTED EXISTING MONUMENT AS BEING THE BEST AVAILABLE EVIDENCE AS TO THE POSITION OF THE ORIGINAL CORNER.
- E-06 [W1/4 COR SEC 16] NO CORNER MONUMENT FOUND. ID CORNER POSITION FROM REMAINS OF McNABB'S 32" PINE STUMP, NOW ONLY A STUMP WITH MEASURING NOTCH PLAIN. ACCEPTED THIS POSITION AS BEING A CAREFUL & FAITHFUL PERPETUATION OF THE LOCATION OF THE ORIGINAL CORNER POSITION.

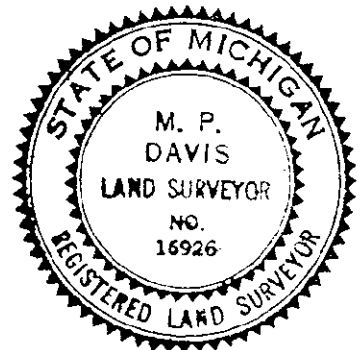

C. Description of monument for corner and accessories established to perpetuate locating the position of the corner:

- E-04 REPLACED EXISTING MON W/A 5/8 X 18" REBAR W/A 3 1/4" ALUM CAP STAMPED TO ID THE CORNER POSITION & SET 6" BELOW GRADE.
POWER POLE MAPLE 09" MAPLE 12" SURVEY MONUMENT SIGN POST
N34°E S44°E S33°W NORTH
29.90' 45.70' 57.22' 15.77' (TO FACE)
- E-06 SET A BERNTSEN AINB30 ALUM MONUMENT W/A 3 1/4" CAP STAMPED TO ID THE CORNER POSITION.
MAPLE 17" MAPLE 06" MAPLE 09" MAPLE 08" SURVEY MONUMENT SIGN POST
N74°W N65°E S35°E S50°W NORTH
4.95' 47.28' 40.72' 4.95' 2.10' (TO FACE)

NOTE: BEARINGS TO REFERENCE OBJECTS ARE MAGNETIC & DISTANCES ARE TO A NAIL W/A REFERENCE TAG UNLESS OTHERWISE NOTED.

Signed by M.P. Davis Date 9/22/98
Surveyor's Michigan License No. 16926