SURVEY & REMONUMENTATION

JAN 14 1998

Approved By Delta County Land Survey Remonumentation Peer Group Under Act 345 Of P.A. Of 1990 On 12/18, 1992

Acting Chairman

LAND CORNER RECORDATION CERTIFICATE

Filing Requirement of Act 74, Mich. P.A. 1970

For corners in SECTION

DELTA (County)

	Located In:	Corner Code #
1. Public Land Survey	T 41 N R 22 W	E-07 & E-08
	T ___ R ___	
	T ___ R ___	
	T ___ R ___	
2. Property Controlling	S ___ T ___ R ___	
in Section	S ___ T ___ R ___	
3. Miscellaneous	S ___ T ___ R ___	
Property in Sec.	S ___ T ___ R ___	

Dec 19 1997
9:00 AM
8 260

Register of Deeds Stamp & File Number

4. Lot No. _____, Recorded Plat _____
5. Private Claims _____
E-07 [NW COR S.21] E-08 [W1/4 S.21]

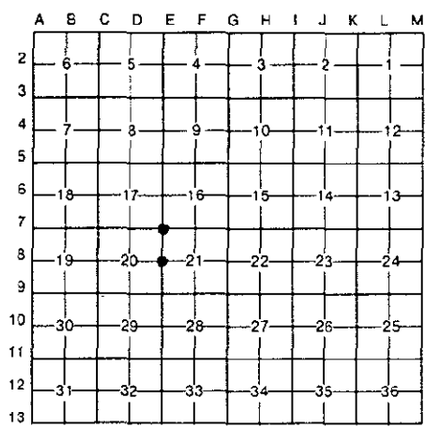

I, M.P. DAVIS, in a field survey on OCTOBER, 19 97, do hereby certify that under requirements of P.A. 74, Michigan P.A. of 1970, the corner points mentioned in lines 1 and 2 above were in conformance with regulations and rules therefore as required in the current manual of survey instructions of the United States Department of the Interior, Bureau of Land *Management or by a decree of a Court of Law and/or that the corner points mentioned in lines 3, 4 and 5* above were in conformance with the rules of the Michigan Board of Land Surveyors or by a Decree of a Court of Law; established, re-established, monumented, re-monumented, recovered, found as expressed below:

NOTE: Not more than 4 corners, all in the same town and range, may be recorded on this certificate.

A. Description of original monument and accessories and/or subsequent restoration:

E-07 [NW COR SEC 21] A.MERRYWEATHER,DS-1845-WOOD POST-(W.BIRCH 10"-S55°E-09 LINKS)(HEMLOCK ??"-N30°W-31 LINKS) M.S.McNABB-1914-ID BY STAKE IN PLACE, CLAIMED BY SETTLERS TO BE CORRECT-SET IRON PIPE M.S.McNABB-1922-FROM PREVIOUS SURVEY (TELE POLE-S28°W-57')(COR FENCE POST-N20°W-27.5') T.OBRIEN-1979-FOUND IRON RAIL PLATE (FENCE COR N30°W-48.1)(FENCE COR-S40°E-44.7') REC'D L.3 PG 252 OF LCR'S

E-08 [W1/4 COR SEC 21] A.MERRYWEATHER, DS - 1847 - WOOD POST - (HEMLOCK 10"-N40°W-07 LINKS)(HEMLOCK 06"-S42°E-22 LINKS) T.O'BRIEN-1981-SET BY PROPORTIONATE DISTANCE BETWEEN SEC COR'S N & S-SET COUNTY MONUMENT (MAPLE 08"-N20°E-52.2')(POPLAR 06" S22°W-44.45')(POPLAR 04"-S25°E-46.15') REC'D. L.5 OF LCR'S ON PG. 39.

B. *Description of corner evidence found and/or method applied in restoring or reestablishing corner:*

E-07 [NW COR SEC 21] FOUND IN PLACE 3/4" IRON PIPE, NO EVIDENCE OF O'BRIEN RAIL PLATE TO BE FOUND. IRON PIPE MONUMENT CHECKS WELL FOR DISTANCE & ALIGNMENT EAST TO THE 1/16 & N1/4 CORNERS WITH THE RECORDS OF McNABB. ACCEPTED EXISTING MONUMENT AS BEING THE BEST AVAILABLE EVIDENCE AS TO THE POSITION OF THE ORIGINAL CORNER.

E-08 [W1/4 COR SEC 21] FOUND IN PLACE, COUNTY MONUMENT AS SET BY O'BRIEN, BADLY BENT & IN POOR CONDITION FROM RECENT RECONSTRUCTION OF THE E-W COUNTY ROAD. STRAIGHTENED AND RESET AS BEST COULD BE DONE. ID CORNER POSITION FROM O/BRIEN'S MAPLE BT NE STILL GREEN.

STATE OF MICHIGAN
M. P. DAVIS
LAND SURVEYOR
NO. 16926
REGISTERED LAND SURVEYOR

C. Description of monument for corner and accessories established to perpetuate locating the position of the corner:

E-07 SET, OVER EXISTING MONUMENT, A 5/8 X 18" REBAR W/A 3 1/4" ALUM CAP STAMPED TO ID THE CORNER POSITION.

POWER POLE	TAMARACK 07"	GAS TRANSMISSION LINE POST # 6	SURVEY MONUMENT SIGN POST
N33°W	S55°E	S56°W	SOUTH
54.00'	67.24'	62.18'	24.95' (TO FACE)

E-08 DID NOT DISTURB EXISTING MONUMENT & RAISED TO GRADE W/A MONUMENT BOX.

CEDAR 05"	SPRUCE 06"	ELM 04"	ELM 06"	SURVEY MONUMENT SIGN POST
N29°W	N20°E	S370E	S42°W	S07°W
25.72'	22.50'	42.10'	39.79'	22.93' (TO FACE)

NOTE: BEARINGS TO REFERENCE OBJECTS ARE MAGNETIC & DISTANCES ARE TO A NAIL W/A REFERENCE TAG UNLESS OTHERWISE NOTED.

Signed by M.P. Davis Date 12/9/97

Surveyor's Michigan License No. 16926

FORM APPROVED BY MICHIGAN STATE BOARD OF LAND SURVEYORS, JAN. 28, 1971
REVISED MAY 14, 1975
REVISED JAN., 1983