

SURVEY & REMONUMENTATION

JAN 14 1998

SECTION

LAND CORNER RECORDATION CERTIFICATE

Filing Requirement of Act 74, Mich. P.A. 1970

Approved By Delta County
Land Survey Remonumentation
Peer Group Under Act 345 Of
P.A. Of 1990 On 12/18, 1992
R. H. Schmeling
Acting Chairman

For corners in
DELTA
(County)

Located In: _____ Corner Code # _____

- | | | | | | | | | | |
|------------------------------------|---|----|---|---|----|---|--|--|--|
| 1. Public Land Survey | T | 41 | N | R | 22 | W | | | |
| | T | 42 | N | R | 22 | W | | | |
| | T | | | R | | | | | |
| | T | | | R | | | | | |
| 2. Property Controlling in Section | S | | T | | R | | | | |
| | S | | T | | R | | | | |
| 3. Miscellaneous Property in Sec. | S | | T | | R | | | | |
| | S | | T | | R | | | | |

F-01 & (F-03)
F-13

Dec 19 1997
9:00 AM
Lib 8 Page 277
John E. ...

Register of Deeds Stamp & File Number

4. Lot No. _____, Recorded Plat _____
5. Private Claims _____
F-01 [N1/4 COR S.4] SAME COR AS F-13 F-03 [N1/4 S.9]

| | | | | | | | | | | | | | |
|----|----|---|----|---|----|---|----|---|----|---|----|---|---|
| | A | B | C | D | E | F | G | H | I | J | K | L | M |
| 2 | 6 | | 5 | | 4 | | 3 | | 2 | | 1 | | |
| 3 | | | | | | | | | | | | | |
| 4 | 7 | | 8 | | 9 | | 10 | | 11 | | 12 | | |
| 5 | | | | | | | | | | | | | |
| 6 | 18 | | 17 | | 16 | | 15 | | 14 | | 13 | | |
| 7 | | | | | | | | | | | | | |
| 8 | 19 | | 20 | | 21 | | 22 | | 23 | | 24 | | |
| 9 | | | | | | | | | | | | | |
| 10 | 30 | | 29 | | 28 | | 27 | | 26 | | 25 | | |
| 11 | | | | | | | | | | | | | |
| 12 | 31 | | 32 | | 33 | | 34 | | 35 | | 36 | | |
| 13 | | | | | | | | | | | | | |

I, M.P. DAVIS, in a field survey on OCTOBER, 1997, do hereby certify that under requirements of P.A. 74, Michigan P.A. of 1970, the corner points mentioned in lines 1 and 2 above were in conformance with regulations and rules therefore as required in the current manual of survey instructions of the United States Department of the Interior, Bureau of Land Management or by a decree of a Court of Law and/or that the corner points mentioned in lines 3, 4 and 5 above were in conformance with the rules of the Michigan Board of Land Surveyors or by a Decree of a Court of Law; established, re-established, monumented, re-monumented, recovered, found as expressed below:

NOTE: Not more than 4 corners, all in the same town and range, may be recorded on this certificate.

A. Description of original monument and accessories and/or subsequent restoration:


F-01 [N1/4 COR SEC 4] JOHN BURT, DS-1845-WOOD POST-(B.ASH 04"-N30'E-26 LINKS)(B.ASH 04"-N46'W-06 LINKS) D.A.BROTHERTON-1909-STAKE IN PLACE SAID TO HAVE BEEN SET BY SURVEYOR CRAIG (STONES-N47'W-35.8' & S47'E-33.0')

F-03 [N1/4 COR SEC 9] A.MERRYWEATHER, DS - 1847 - WOOD POST - (B.ASH 12"-S85'W-28 LINKS)(HEMLOCK 14"-N66'E-51LINKS) M.S.McNABB-1939-SURVEY REC'DS FOR SURVEY OF PERKINS CEMETERY SHOW CORNER IN PLACE, NO DESCRIPTION OF MONUMENT GIVEN OR WIT'S NOTED.

B. Description of corner evidence found and/or method applied in restoring or reestablishing corner:

F-01 [N1/4 COR SEC 4] FOUND IN PLACE & IN POOR CONDITION A 3/4" IRON PIN, NO EVIDENCE OF BROTERTON'S STONE BT'S FOUND. AREA HAS BEEN GREATLY DISTURBED IN RECENT ROAD CONSTRUCTION. EXISTING MONUMENT FALLS VERY NEARLY AT THE MIDPOINT AND ON LINE WITH THE ADJOINING SEC COR'S E & W. ACCEPTED EXISTING MONUMENT AS BEING BEST AVAILABLE EVIDENCE AS TO THE POSITION OF THE ORIGINAL CORNER.

F-03 [N1/4 COR SEC 9] NO CORNER EVIDENCE TO BE FOUND. CORNER POSITION FALLS IN A 7' M/L FILL SECTION FOR THE E-W COUNTY ROAD. RESTORED CORNER POSITION FROM RETRACEMENT OF McNABB'S 1939 SURVEY OF THE PERKINS CEMETERY (DEEDS REC'D IN LIBER 'O' PG. 20 & LIBER 111 PG. 48) ACCEPTED AS BEING THE BEST AVAILABLE EVIDENCE AS TO THE LOCATION OF THE POSITION OF THE ORIGINAL CORNER.

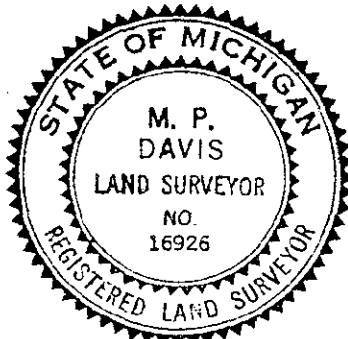

C. Description of monument for corner and accessories established to perpetuate locating the position of the corner:

F-01 REPLACED EXISTING MONUMENT, W/A 5/8 X 18" REBAR W/A 3 1/4" ALUM CAP STAMPED TO ID THE CORNER POSITION.
 POWER POLE CEDAR 13' ELM 04" SPRUCE 16' SURVEY MONUMENT SIGN POST
 N50°E S56°W S32°E N02°W SOUTH
 26.80' 32.33' 35.00' 79.33' 16.65' (TO FACE)

F-03 SET, 6" BELOW GRADE, A 5/8 X 18" REBAR W/A 3 1/4" ALUM CAP STAMPED TO ID THE CORNER POSITION.
 MAPLE 10" SPRUCE 11" W.BIRCH 10" TAMARACK 18"
 N65°E N52°W S53°W S30°E
 38.58' 60.52' 66.00' 50.68'

NOTE: BEARINGS TO REFERENCE OBJECTS ARE MAGNETIC & DISTANCES ARE TO A NAIL W/A REFERENCE TAG UNLESS OTHERWISE NOTED.

Signed by M.P. Davis Date 11/21/97

Surveyor's Michigan License No. 16926