

# SURVEY & REMONUMENTATION

JAN 14 1998

SECTION

## LAND CORNER RECORDATION CERTIFICATE Filing Requirement of Act 74, Mich. P.A. 1970

Approved by Delta County  
Land Survey Remonumentation  
Peer Group Under Act 345 Of  
P.A. Of 1990 On 12/18, 1992

*Michael Schmeling*  
Acting Chairman

For corners in  
DELTA  
(County)

Located In: Corner Code #

- |                                    |                            |                        |
|------------------------------------|----------------------------|------------------------|
| 1. Public Land Survey              | T <u>41</u> NR <u>22</u> W | <u>G-03 &amp; G-04</u> |
|                                    | T _____ R _____            | _____                  |
|                                    | T _____ R _____            | _____                  |
|                                    | T _____ R _____            | _____                  |
| 2. Property Controlling in Section | S _____ T _____ R _____    | _____                  |
|                                    | S _____ T _____ R _____    | _____                  |
| 3. Miscellaneous Property in Sec.  | S _____ T _____ R _____    | _____                  |
|                                    | S _____ T _____ R _____    | _____                  |

Date: Dec 19 1997  
at 9:00 AM  
8 258  
*William E. Thomas*

Register of Deeds Stamp & File Number

4. Lot No. \_\_\_\_\_, Recorded Plat \_\_\_\_\_
5. Private Claims G-03 [NW COR S.10] G-04 [W1/4 S.10]

	A	B	C	D	E	F	G	H	I	J	K	L	M
2	6	5	4	3	2	1							
3							●						
4	7	8	9	10	11	12							
5													
6	18	17	16	15	14	13							
7													
8	19	20	21	22	23	24							
9													
10	30	29	28	27	26	25							
11													
12	31	32	33	34	35	36							
13													

I, M.P. DAVIS, in a field survey on OCTOBER, 19 97, do hereby certify that under requirements of P.A. 74, Michigan P.A. of 1970, the corner points mentioned in lines 1 and 2 above were in conformance with regulations and rules therefore as required in the current manual of survey instructions of the United States Department of the Interior, Bureau of Land Management or by a decree of a Court of Law and/or that the corner points mentioned in lines 3, 4 and 5 above were in conformance with the rules of the Michigan Board of Land Surveyors or by a Decree of a Court of Law; established, re-established, monumented, re-monumented, recovered, found as expressed below:

**NOTE: Not more than 4 corners, all in the same town and range, may be recorded on this certificate.**

**A. Description of original monument and accessories and/or subsequent restoration:**


G-03 [NW COR SEC 10] A.MERRYWEATHER, D.S. - 1847 - WOOD POST (SUGAR 26°-S50°E-05 LINKS) (SUGAR 11°-N50°W-20 LINKS) M.S.McNABB-1920-ID BY + ON STONE NOTED NEW BT'S (ELM 10°-S45°W-44') (COR FENCE POST-SE-44' & NORTH 31.5')

G-04 [W1/4 COR SEC 10] A.MERRYWEATHER, D.S. - 1847 - WOOD POST - CEDAR 18°-CORNER TREE-(SPRUCE 09°-NORTH-05 LINKS) D.A.BROTHERTON-1895-ID FROM ORIGINALS -SET NEW STAKE-NO NEW WIT'S NOTED M.S.McNABB-1920-ID BY STAKE & BT STAKES IN PLACE-SET IRON BOLT (GATE POST WEST-1.7') (CEDAR STUMP 7°-S45°E-25')

**B. Description of corner evidence found and/or method applied in restoring or reestablishing corner:**

G-03 [NW COR SEC 10] FOUND IN PLACE A 1 1/2" IRON PIN OVER LARGE STONE. McNABB'S ELM BT NOW A BADLY DECAYED STUMP, NO IRON MARKS VISIBLE. ACCEPTED EXISTING MONUMENT AS BEING THE BEST AVAILABLE EVIDENCE AS TO THE POSITION OF THE ORIGINAL CORNER.

G-04 [W1/4 COR SEC 10] FOUND IN PLACE McNABB'S IRON BOLT, ID CORNER POSITION FROM REMAINS OF GATE POST BT (FOUND REMAINS OF 8" POST NOW DECAYED TO 6" BELOW THE SURFACE) 1.7' TO THE WEST. ACCEPTED EXISTING MONUMENT AS BEING A CAREFUL & FAITHFUL PERPETUATION OF THE POSITION OF THE ORIGINAL CORNER.

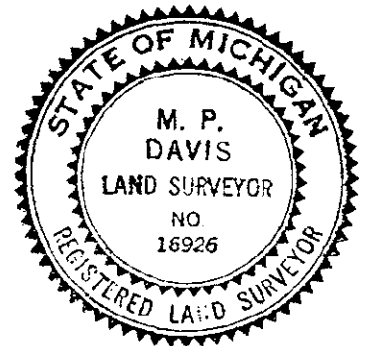

**C. Description of monument for corner and accessories established to perpetuate locating the position of the corner:**

G-03 SET, OVER EXISTING MON, A 5/8 x 10" REBAR W/A 3 1/4" ALUM CAP STAMPED TO ID THE COR POSITION.  

MAPLE 18"	MAPLE 13"	MAPLE 03'	POWER POLE	SURVEY MONUMENT SIGN POST
N57°W	S55°E	S42°W	N2°E	S7°W
75.98'	43.00'	36.25'	29.22'	16.73' (TO FACE)

G-04 SET, OVER EXISTING MON, A BERNTSEN ALNB30 ALUM MONUMENT WITH THE CAP STAMPED TO ID THE COR POSITION.  

CEDAR 05"	ASH 06"	ELM 06"	ELM 07"	SURVEY MONUMENT SIGN POST
N54°W	S80°E	S24°E	S42°W	NORTH
44.50'	24.24'	48.68'	38.74'	2.77' (TO FACE)

NOTE: BEARINGS TO REFERENCE OBJECTS ARE MAGNETIC & DISTANCES ARE TO A NAIL W/A REFERENCE TAG UNLESS OTHERWISE NOTED.

Signed by M.P. Davis 11/27/97 Date \_\_\_\_\_  
 Surveyor's Michigan License No. 16926