

SURVEY & REMONUMENTATION

JAN 14 1998

SECTION

LAND CORNER RECORDATION CERTIFICATE
Filing Requirement of Act 74, Mich. P.A. 1970

Approved By Delta County
Land Survey Remonumentation
Peer Group Under Act 345 Of
P.A. Of 1990 On 12/18, 1997
Ruth Schmeling
Acting Chairman

For corners in
DELTA
(County)

Located In: Corner Code #

- | | | | |
|------------------------------------|-----------------------------|-------------|-------|
| 1. Public Land Survey | T <u>41</u> N R <u>22</u> W | G-05 & H-05 | |
| | T _____ R _____ | _____ | _____ |
| | T _____ R _____ | _____ | _____ |
| | T _____ R _____ | _____ | _____ |
| 2. Property Controlling in Section | S _____ T _____ R _____ | _____ | _____ |
| | S _____ T _____ R _____ | _____ | _____ |
| 3. Miscellaneous Property in Sec. | S _____ T _____ R _____ | _____ | _____ |
| | S _____ T _____ R _____ | _____ | _____ |

Recorded Dec 19 1997
at 9:00 AM
Lib. 8 257

Register of Deeds Stamp & File Number

4. Lot No. _____, Recorded Plat _____
5. Private Claims G-05 [NW COR S.15] H-05 [N1/4 S.15]

	A	B	C	D	E	F	G	H	I	J	K	L	M
2	6	5	4	3	2	1							
3													
4	7	8	9	10	11	12							
5													
6	18	17	16	15	14	13							
7													
8	19	20	21	22	23	24							
9													
10	30	29	28	27	26	25							
11													
12	31	32	33	34	35	36							
13													

I, M.P. DAVIS, in a field survey on OCTOBER, 19 97, do hereby certify that under requirements of P.A. 74, Michigan P.A. of 1970, the corner points mentioned in lines 1 and 2 above were in conformance with regulations and rules therefore as required in the current manual of survey instructions of the United States Department of the Interior, Bureau of Land Management or by a decree of a Court of Law and/or that the corner points mentioned in lines 3, 4 and 5 above were in conformance with the rules of the Michigan Board of Land Surveyors or by a Decree of a Court of Law; established, re-established, monumented, re-monumented, recovered, found as expressed below:

NOTE: Not more than 4 corners, all in the same town and range, may be recorded on this certificate.

A. Description of original monument and accessories and/or subsequent restoration:


- G-05 [NW COR SEC 15] A.MERRYWEATHER, D.S. - 1847 - WOOD POST (SUGAR 20"-S70°W-33 LINKS) (SUGAR 18"-N70°E-22 LINKS)
D.A. BROTHERTON - 1910 - SET STAKE FROM OLD BT STAKES S45°E-40' & N49°W-43' (COR FENCE POST S39°E-41' & N46°W-46.3')
M.S. McNABB - 1920 - ID BY STAKE & BT STAKES IN PLACE
M.S. McNABB - 1922 - FROM PREVIOUS SURVEY - DROVE IRON BOLT ALONG SIDE OF STAKE (CORNER FENCE POST N45°W-46.5" & S45°E-44.5")
R.E. SCHMELING - 1959 - L.3 OF LCR'S PG. 103 - IRON PIN IN PLACE (PP N30°E-76') (ELM 15"-N53°W-55') (USFS POST - S28°W-30.0')

- H-05 [N1/4 COR SEC 15] A.MERRYWEATHER, D.S. - 1847 - WOOD POST - (CEDAR 06"-N80°W-14 LINKS) (CEDAR 06"-S70°E-13 LINKS)
M.S. McNABB - 1920 - ID BY STAKE PLACE - NOTED NEW BT'S (TAMARACK STUMP N45°W-29') (CEDAR STUMP 10"-SOUTH-66.7') (CEDAR STUMP - N40°E-26.6')
R.E. SCHMELING - 1959 - L.3 OF LCR'S PG 92 - SET GALV I.P. W/A BRASS CAP - NEW BT'S (TAMARACK 08"-N18°W-108.5 LINKS) (CEDAR 6"-S49°W-71 LINKS) (CEDAR 6"-S24°W-47 LINKS)

B. Description of corner evidence found and/or method applied in restoring or reestablishing corner:

G-05 [NW COR SEC 15] FOUND IN PLACE & 5' SOUTH OF THE C/L OF THE E-W COUNTY ROAD AN IRON BOLT. ID CORNER POSITION FROM REMAINS OF SCHMELING'S ELM BT (NOW A BADLY DECAYED STUMP, NO IRON MARKS VISIBLE. CORNER MONUMENT CHECKS WELL WITH McNABB'S CALL TO THE BRIDGE CROSSING TO THE EAST & TO HIS W1/16 COR AS FOUND IN PLACE. ACCEPTED EXISTING MONUMENT AS BEING THE BEST AVAILABLE EVIDENCE AS TO THE POSITION OF THE ORIGINAL CORNER.

H-05 [N1/4 COR SEC 15] NO EVIDENCE OF SCHMELING'S 1959 CORNER MONUMENT OR ACCESSORIES FOUND, AS ALL HAVE APPARENTLY BEEN DESTROYED IN ROAD IMPROVEMENTS. EXTENDED LINE EAST FROM NW COR OF SEC 15 THRU THE W1/16 (FOUND McNABB'S CORNER MONUMENT IN PLACE) & REESTABLISHED THE 1/4 CORNER ON THIS LINE AT A PROPORTIONATE DISTANCE EAST OF THE W1/16. ACCEPTED THIS LOCATION AS BEING THE BEST AVAILABLE EVIDENCE AS TO THE LOCATION OF THE POSITION OF THE ORIGINAL CORNER.

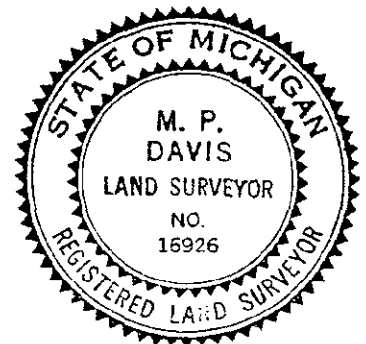

C. Description of monument for corner and accessories established to perpetuate locating the position of the corner:

G-05 SET, OVER EXISTING MON, A 5/8 X 18" REBAR W/A 3 1/4" ALUM CAP STAMPED TO ID THE COR POSITION, RAISED TO GRADE W/A MON BOX

SEASONAL RD SIGN POST	COR FENCE POST	CEDAR FENCE POST	NORTH LEG "ONE LANE BRIDGE" SIGN POST
N02°W	S40°E	SOUTH	S40°W
55.57'	25.00'	17.37'	15.50'

H-05 SET, 6" BELOW GRADE, A 5/8 X 18" REBAR W/A 3 1/4" ALUM CAP STAMPED TO ID THE COR POSITION.

CEDAR 09"	CEDAR 08"	CUT NOTCH ON (NORTH END OF CMP) (ON SOUTH END OF CMP)	SURVEY MONUMENT SIGN POST
S42°W	S05°W	N70°E	S65°E
55.20'	36.43'	43.50'	42.40'
			17.32' (TO FACE)

NOTE: BEARINGS TO REFERENCE OBJECTS ARE MAGNETIC & DISTANCES ARE TO A NAIL W/A REFERENCE TAG UNLESS OTHERWISE NOTED.

Signed by M.P. DAVIS Date 11/27/97
Surveyor's Michigan License No. 16926