

**SURVEY & REMONUMENTATION**

SEP 18 1997

COMMISSION

**LAND CORNER RECORDATION CERTIFICATE**  
Filing Requirement of Act 74, Mich. P.A. 1970

Approved By Delta County  
Land Survey Remonumentation  
Peer Group Under Act 345 Of  
P.A. Of 1990 On July 23, 1997

*Robert B. Hamilton*  
Chairman

For corners in  
DELTA  
(County)

Located in: Corner Code #/

- |                                    |   |    |   |   |    |   |                        |
|------------------------------------|---|----|---|---|----|---|------------------------|
| 1. Public Land Survey              | T | 41 | N | R | 23 | W | <u>D-13 &amp; E-02</u> |
|                                    | T |    | R |   |    |   |                        |
|                                    | T |    | R |   |    |   |                        |
|                                    | T |    | R |   |    |   |                        |
| 2. Property Controlling in Section | S |    | T |   | R  |   |                        |
|                                    | S |    | T |   | R  |   |                        |
| 3. Miscellaneous Property in Sec.  | S |    | T |   | R  |   |                        |
|                                    | S |    | T |   | R  |   |                        |

28 July 1997  
9:00 o'clock a.m.  
Line 8 Page 215  
*William C. Thomas*  
Delta County, Reg. of Deeds

Register of Deeds Stamp & File Number

4. Lot No. \_\_\_\_\_, Recorded Plat \_\_\_\_\_  
5. Private Claims D-13 S1/4 COR SEC 32 E-02 W1/4 COR SEC 4

	A	B	C	D	E	F	G	H	I	J	K	L	M
2	6		5		4		3		2		1		
3													
4	7		8		9		10		11		12		
5													
6	13		17		16		15		14		13		
7													
8	19		20		21		22		23		24		
9													
10	30		29		28		27		26		25		
11													
12	31		32		33		34		35		36		
13													

I, M.P. DAVIS in a field survey on 8 MAY/16 JUNE, 19 97, do hereby certify that under requirements of P.A. 74, Michigan P.A. of 1970, the corner points mentioned in lines 1 and 2 above were in conformance with regulations and rules therefore as required in the current manual of survey instructions of the United States Department of the Interior, Bureau of Land Management or by a decree of a Court of Law and/or that the corner points mentioned in lines 3, 4 and 5 above were in conformance with the rules of the Michigan Board of Land Surveyors or by a Decree of a Court of Law; established, re-established, monumented, re-monumented, recovered, found as expressed below:

**NOTE: Not more than 4 corners, all in the same town and range, may be recorded on this certificate.**

A. Description of original monument and accessories and/or subsequent restoration:


D-13 [S1/4 COR SEC 32]- WILLIAM BYRT, D.S. -1844-WOOD POST (CEDAR 20°-N25°W-35 LINKS)(CEDAR 18°-N30°E-19 LINKS)  
D.A. BROTHERTON-1903-ID FROM STUMP OF ORIGINAL, NO NEW BT'S NOTED  
M.S. McNABB-1913-IRON PIPE & BT BY BROTHERTON  
M.S. McNABB-1914-FOR ROAD COMMISSION-FROM PREVIOUS SURVEY  
M.S. McNABB-1920-FROM PREVIOUS SURVEY-PP N85°W 21.5'

E-02 [W1/4 COR SEC 4] A. MERRYWEATHER, D.S. -1847-WOOD POST (BALSAM 05°-S05°W-09 LINKS)(TAMARAC 07°-N10°E-22 LINKS)  
M.S. McNABB-AUGUST 1913-OLD STAKE & REMAINS OF ORIGINALS  
M.S. McNABB-AUGUST 1913-ORIGINALS DESTROYED ADOPTED POST SET ON LINE WITH CORNERS N & S  
NOTE BY M DAVIS-APPEARS TO BE A CONFLICT AS SHOWN IN THE RECORDS OF McNABB

B. Description of corner evidence found and/or method applied in restoring or reestablishing corner:

D-13 [S1/4 COR SEC 32] FOUND IN PLACE & 3' M/L BELOW COUNTY RD SURFACE A 1" IRON PIPE. NO EVIDENCE OF McNABB'S PP BT FOUND. DISTANCE (53.5' R & M) CHECKS TO THE N1/4 COR OF SEC 1 T40N R24W. ACCEPTED EXISTING MONUMENT AS BEING A CAREFUL & FAITHFUL PERPETUATION OF THE POSITION OF THE ORIGINAL CORNER

E-02 [W1/4 COR SEC 4] NO CORNER EVIDENCE FOUND. ESTABLISHED CORNER POSITION ON LINE WITH AND PROPORTIONATE DISTANCE BETWEEN SEC COR'S 1/2 MILE TO THE NORTH & SOUTH.

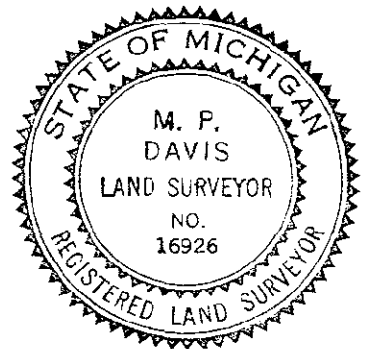

C. Description of monument for corner and accessories established to perpetuate locating the position of the corner:

D-13 SET OVER EXISTING MON A 5/8"X18" REBAR W/A 3 1/4" ALUM CAP STAMPED TO ID THE COR POSITION & RAISED TO GRADE W/A MON BOX  
5/8" X 18" REBARS W/A 2" ALUM WIT'S CAP SURVEY MONUMENT SIGN POST N1/4 COR SEC 1 T40N R24W  
S45°W 29.47' S45°E 38.13' NORTH 16.13' (TO FACE) WEST 53.50'

E-02 SET A BERNTSEN ALNB30 ALUM MON WITH THE CAP STAMPED TO ID THE CORNER POSITION.  
ASH 4" ASH 8" ASH 6" ASH 8" SURVEY MONUMENT SIGN POST NEW FOUR STRAND E-W BARBED WIRE FENCE  
N37°W 27.96' N60°E 18.23' S72°E 18.45' S65°W 15.93' NORTH 1.42' (TO FACE) SOUTH 16.3'

NOTE: BEARINGS TO REFERENCE OBJECTS ARE MAGNETIC & DISTANCES ARE TO A NAIL IN THE CENTER OF THE OBJECT, UNLESS OTHERWISE NOTED.

Signed by M.P. Davis Date 7/23/97  
Surveyor's Michigan License No. 16926