

SURVEY & REMONUMENTATION

JAN 14 1998

Approved By Delta County
Land Survey Remonumentation
Peer Group Under Act 345 Of
P.A. Of 1990 On 12/18, 1992
Robert Schmalzing
Acting Chairman

LAND CORNER RECORDATION CERTIFICATE

Filing Requirement of Act 74, Mich. P.A. 1970

SECTION

For corners in

DELTA

(County)

Located In:

Corner Code ##

- | | | | | | |
|------------------------------------|---|-------------|---|-------------|------------------------|
| 1. Public Land Survey | T | <u>41</u> N | R | <u>23</u> W | <u>E-08 & E-10</u> |
| | T | _____ | R | _____ | _____ |
| | T | _____ | R | _____ | _____ |
| | T | _____ | R | _____ | _____ |
| 2. Property Controlling in Section | S | _____ | T | _____ | _____ |
| | S | _____ | T | _____ | _____ |
| 3. Miscellaneous Property in Sec. | S | _____ | T | _____ | _____ |
| | S | _____ | T | _____ | _____ |

Recorded DEC 19 1997
at 9:00 am
8 254
Robert Schmalzing

Register of Deeds Stamp & File Number

4. Lot No. _____, Recorded Plat _____
5. Private Claims E-08 W1/4 COR SEC 21 E-10 W1/4 COR SEC 28

	A	B	C	D	E	F	G	H	I	J	K	L	M
2	6	5	4	3	2	1							
3													
4	7	8	9	10	11	12							
5													
6	18	17	16	15	14	13							
7													
8	19	20	21	22	23	24							
9													
10	30	29	28	27	26	25							
11													
12	31	32	33	34	35	36							
13													

I, M.P. DAVIS, in a field survey on 03 JUNE, 19 97, do hereby certify that under requirements of P.A. 74, Michigan P.A. of 1970, the corner points mentioned in lines 1 and 2 above were in conformance with regulations and rules therefore as required in the current manual of survey instructions of the United States Department of the Interior, Bureau of Land Management or by a decree of a Court of Law and/or that the corner points mentioned in lines 3, 4 and 5 above were in conformance with the rules of the Michigan Board of Land Surveyors or by a Decree of a Court of Law; established, re-established, monumented, re-monumented, recovered, found as expressed below:

NOTE: Not more than 4 corners, all in the same town and range, may be recorded on this certificate.

A. Description of original monument and accessories and/or subsequent restoration:


E-08 [W1/4 COR SEC 21]- A.MERRYWEATHER, D.S.-1847-WOOD POST (CEDAR 06°-N70°E-09 LINKS)(CEDAR 07°-S85°W-08 LINKS)
M.S.McNABB-1933-ROAD ALIGNMENT SURVEY FOR DELTA COUNTY ROAD 519-IRON STAKE IN PLACE-TAM 8" S60°W 52' PINE STAKE N73°E 32.5'

E-10 [W1/4 COR SEC 28] A.MERRYWEATHER, D.S.-1847-WOOD POST (BURNT SPRUCE 05°-EAST -10 LINKS)(BURNT TAMERAC 07°-N80°W-14 LINKS)
M.S.McNABB-1933-ROAD ALIGNMENT SURVEY FOR DELTA COUNTY ROAD 519-STAKE IN PLACE-PINE STUMP 36"-S35°E-26.25' SPRUCE 9' S51°W 53'.
M.S.McNABB-1944-STAKE IN PLACE 1.56' EAST OF DIRECT LINE BETWEEN CORNERS-DROVE IRON STAKE NO NEW WIT'S NOTED

B. Description of corner evidence found and/or method applied in restoring or reestablishing corner:

E-08 [W1/4 COR SEC 21] NO EVIDENCE FOUND OF McNABB'S 1933 MONUMENT OR BT'S. FOUND IN PLACE A TRACK SPIKE BY PERSONS UNKNOWN. DISTANCE SOUTH 1/2 MILE TO DNR CORNER CHECKS WELL WITH McNABB'S 1933 ROAD ALIGNMENT SURVEY, THE DISTANCE NORTH 1/2 MILE IS 12'M/L SHORT OF McNABB'S DISTANCE. EXISTING MON FITS WELL WITH FARM OCCUPATION TO THE EAST & TIMBER OPERATION TO THE WEST. ACCEPTED EXISTING MON AS BEING THE BEST AVAILABLE EVIDENCE AS TO THE LOCATION OF THE POSITION OF THE ORIGINAL CORNER.

E-10 [W1/4 COR SEC 28] NO EVIDENCE FOUND OF McNABB'S 1933 MONUMENT OR BT'S-REPLACED CORNER POSITION 1.56' EAST OF A DIRECT LINE & PROPORTIONATE DISTANCE BETWEEN SEC COR'S 1/2 MILE N & S. ACCEPTED THIS LOCATION AS BEING THE BEST AVAILABLE EVIDENCE AS TO THE POSITION OF THE ORIGINAL CORNER.

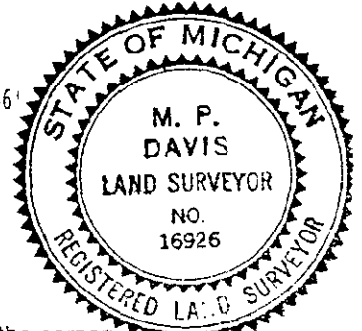

C. Description of monument for corner and accessories established to perpetuate locating the position of the corner:

E-08 REPLACE EXISTING MON W/A 5/8" X 18" REBAR W/A 3 1/4" ALUM CAP STAMPED TO ID THE COR POSITION & RAISED TO GRADE W/A MON BOX
5/8" X 18" REBAR W/A 2" ALUM WIT'S CAP DRILL HOLE IN LARGE FIELD STONE SURVEY MONUMENT SIGN POST
N48°W S18°E S47°W N83°E WEST
24.05' 34.86' 28.53' 55.95' 25.84' (TO FACE)

E-10 SET A 5/8" X 18" REBAR W/A 3 1/4" ALUM CAP STAMPED TO ID THE CORNER POSITION & RAISED TO GRADE W/A MONUMENT BOX.
MAPLE 09" MAPLE 06" SPRUCE 07" W.BIRCH 04" SURVEY MONUMENT SIGN POST
N53°W S57°W S72°E N42°E EAST
45.83' 51.95' 56.71' 74.00' 28.76' (TO FACE)

NOTE: BEARINGS TO REFERENCE OBJECTS ARE MAGNETIC & DISTANCES ARE TO A NAIL IN THE CENTER OF THE OBJECT, UNLESS OTHERWISE NOTED.

Signed by M.P. Davis Date 11/24/97
Surveyor's Michigan License No. 16926