

OCT 31 1997

COMMISSION

LAND CORNER RECORDATION CERTIFICATE
Filing Requirement of Act 74, Mich. P.A. 1970

Approved By Delta County Land Survey Remonumentation Peer Group Under Act 345 Of P.A. Of 1990 On July 23, 1997
Acting Chairman

For corners in

Form with fields for DELTA (County), Located in:, Corner Code #, and numbered items 1-5 describing the survey and property details.

Register of Deeds Stamp & File Number. Includes date 28 July 1997, time 9:00 a.m., page 8 of 218, and signature of Walter C. Thorne.

I, M.P. DAVIS, in a field survey on 08 July, 1997, do hereby certify that under requirements of P.A. 74, Michigan P.A. of 1970, the corner points mentioned in lines 1 and 2 above were in conformance with regulations and rules therefore as required in the current manual of survey instructions of the United States Department of the Interior, Bureau of Land Management or by a decree of a Court of Law and/or that the corner points mentioned in lines 3, 4 and 5 above were in conformance with the rules of the Michigan Board of Land Surveyors or by a Decree of a Court of Law; established, re-established, monumented, re-monumented, recovered, found as expressed below:

Grid table with columns A-M and rows 2-13. Contains numerical data points for survey locations.

NOTE: Not more than 4 corners, all in the same town and range, may be recorded on this certificate.

A. Description of original monument and accessories and/or subsequent restoration:


E-11 [NW COR SEC 33]- A.MERRYWEATHER, D.S.-1947-WOOD POST (IRONWOOD 10'-N26'E-26 LINKS)(BEECH 10'-S48'W-29 LINKS) M.S.McNABB-1913-ROAD ALIGNMENT SURVEY FOR DELTA COUNTY ROAD 519-STAKE IN PLACE-SET BY STAKES NW & SE 33' M.S.McNABB-1944-STAKE FROM PREVIOUS SURVEY-DROVE IRON-NO NEW WIT'S NOTED

E-12 [W1/4 COR SEC 33] A.MERRYWEATHER, D.S.-1947-WOOD POST (BURNT CEDAR 07'-N22'E-18 LINKS)(BURNT TAMERAC 06'-S14'W-05 LINKS) M.S.McNABB-1918-SURVEY OF E-W1/4 LINE OF SEC 32-STAKE IN PLACE, ID CORNER FROM ORIGINALS-NBT CEDAR 5'-S80'W-5' M.S.McNABB-1933-ROAD ALIGNMENT SURVEY FOR DELTA COUNTY ROAD 519-STAKE IN PLACE-SET BY STAKES NW & SE 33' M.S.McNABB-1944-STAKE FROM PREVIOUS SURVEY-DROVE IRON STAKE-POPPLE 8'-S40'E-36.5' W.BIRCH 7'-WEST 40.5' M.DAVIS-1974-RESTORED FROM McNABB'S 1944 W.BIRCH BT-SET CONC MON W/A STAMPED BRASS CAP-NBT'S PP WEST 42.7'-BALSAM 8' S42'E 33.5' REC'D IN LIBER 2 OF LCR'S ON PAGE 88

B. Description of corner evidence found and/or method applied in restoring or reestablishing corner:

E-11 [NW COR SEC 33] FOUND IN PLACE & 20" W/L BELOW ROAD SURFACE A 1" IRON PIPE. NO EVIDENCE OF McNABB'S 1944 BT STAKES. DISTANCES N, S & E TO ADJOINING CORNERS CHECK WELL WITH THE RECORDS OF McNABB. ACCEPTED THIS LOCATION AS BEING THE BEST AVAILABLE EVIDENCE AS TO THE POSITION OF THE ORIGINAL CORNER

E-12 [W1/4 COR SEC 33] FOUND IN PLACE THE REMAINS OF THE CONC MON AS PLACED BY MYSELF IN 1974. THE 1974 BT'S HAVE BEEN DESTROYED. DISTANCES TO ADJOINING CORNERS N & E CHECK WELL WITH MY 1974 MEASUREMENTS AFTER STRAIGHTENING AS BEST COULD BE DONE OF THE CONC MON. ACCEPTED THIS LOCATION AS BEING A CAREFULLY AND FAITHFUL PERPETUATION OF THE POSITION OF THE ORIGINAL CORNER.

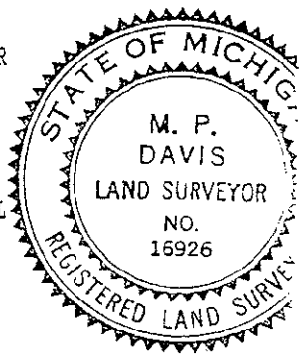

C. Description of monument for corner and accessories established to perpetuate locating the position of the corner:

E-11 SET OVER EXISTING MON A 5/8"x18" REBAR W/A 3 1/4" ALUM CAP STAMPED TO ID THE CORNER POSITION & RAISED TO GRADE W/A MONUMENT BOX. 5/8" X 18" REBARS W/A 2" ALUM WIT'S CAP SURVEY MONUMENT SIGN POST C/L COUNTY RD 519
N45'W 17.30' S45'W 20.50' EAST 29.60' (TO FACE) EAST 3'

E-12 REPLACED REMAINS OF CONC MON W/A BERNTSEN AINB30 ALUM MON W/A 3 1/4" ALUM CAP STAMPED TO ID THE CORNER POSITION.
MAPLE 6" N30'W 39.52' MAPLE 5" S20'E 55.88' ASH 7" S55'W 44.58' POWER POLE WEST 43.03' SURVEY MONUMENT SIGN POST SOUTH 1.15'(TO FACE)

NOTE: BEARINGS TO REFERENCE OBJECTS ARE MAGNETIC & DISTANCES ARE TO A NAIL IN THE CENTER OF THE OBJECT, UNLESS OTHERWISE NOTED.

Signed by M.P. DAVIS Date 7/23/97
Surveyor's Michigan License No. 16926

8 CASE 218