

OCT 3 1997

COMMISSION

LAND CORNER RECORDATION CERTIFICATE
Filing Requirement of Act 74, Mich. P.A. 1970

Approved By Delta County Land Survey Remonumentation Peer Group Under Act 345 Of P.A. Of 1990 On July 23, 1997

Michael Schumling Acting Chairman

For corners in

DELTA (County)

Located In:


Corner Code #

- 1. Public Land Survey T 41 N R 23 W G-12 & G-11
2. Property Controlling in Section S T R
3. Miscellaneous Property in Sec. S T R
4. Lot No. , Recorded Plat
5. Private Claims G-12 W1/4 COR SEC 34 G-11 NW COR SEC 34

28 July 1997
9:00 a.m.
8 220
Walter C. Thoren
Delta County, MI Reg. of Deeds

Register of Deeds Stamp & File Number

I, M.P. DAVIS, in a field survey on 12 JUNE, 19 97, do hereby certify that under requirements of P.A. 74, Michigan P.A. of 1970, the corner points mentioned in lines 1 and 2 above were in conformance with regulations and rules therefore as required in the current manual of survey instructions of the United States Department of the Interior, Bureau of Land Management or by a decree of a Court of Law and/or that the corner points mentioned in lines 3, 4 and 5 above were in conformance with the rules of the Michigan Board of Land Surveyors or by a Decree of a Court of Law; established, re-established, monumented, re-monumented, recovered, found as expressed below:

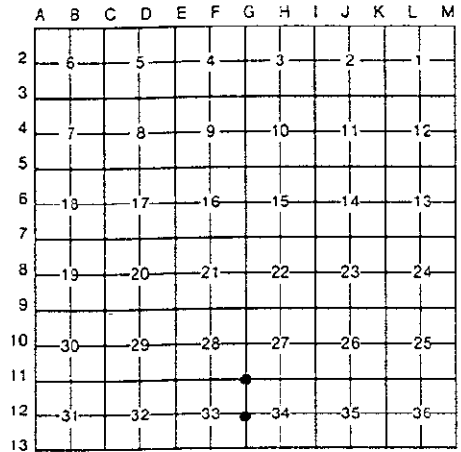


NOTE: Not more than 4 corners, all in the same town and range, may be recorded on this certificate.

A. Description of original monument and accessories and/or subsequent restoration:

- G-12 [W1/4 COR SEC 34] A.MERRYWEATHER, D.S.-1847-WOOD POST (SUGAR MAPLE 18"-S60"E-29 LINKS) (SUGAR MAPLE 07"-N40"W-16 LINKS)
J.S.CRAIG-1900-ID FROM ORIGINALS (SUG BT SE) NO NEW WIT'S NOTED
M.S.McNABB-1943-STAKE IN PLACE-SET IRON BOLT-NO WIT'S NOTED
FRANK BRAY (MICH DNR)-1970-FOUND IRON ROD IN PLACE FROM WHICH (ELM 18"-S36"W-32.2') (POWER POLE-N2"E-38.5') REC'D L.4 PG.167
G-11 [NW COR SEC 34] A.MERRYWEATHER, D.S.-1847-WOOD POST (BURNT SWAMP LIVE TAMERAC 16"-S86"E-360 LINKS)
J.S.CRAIG-1900-ID FROM ORIG'S, IN ALDER SWAMP NO BT'S
M.S.McNABB-1933-SET ASH STK AT USED COR AT CROSS LINES IN ALDER SWAMP FROM WHICH A TAM 8"-S15"W-23.2'

B. Description of corner evidence found and/or method applied in restoring or reestablishing corner:

- G-12 [W1/4 COR SEC 34] FOUND IN PLACE A 1" IRON PIPE APPROX 2' SOUTH OF THE C/L OF THE E-W COUNTY ROAD. THIS MONUMENT APPEARS TO BE A PERPETUATION OF McNABB'S 1943 IRON BOLT & BRAY'S 1970 IRON ROD. DIST'S 1/2 MILE N & 1 MILE WEST CHECK WELL WITH THE RECORD'S OF McNABB & CRAIG & WITH BRAY'S PP BT TO THE NE. ACCEPTED EXISTING MONUMENT AS BEING A CAREFUL & FAITHFUL PERPETUATION OF THE POSITION OF THE ORIGINAL CORNER.
G-11 [NW COR SEC 34] FOUND DOWN & IN THE MUCK A SQ'D. POST SCRIBED WITH THE APPROPRIATE SEC NUMBERS THEREON. ID SAME AS THAT BEING SET BY McNABB FROM HIS TAMARACK BT (NOW A STUMP WITH IRON MARKS BARELY VISIBLE) ACCEPTED EXISTING MONUMENT AS BEING A CAREFUL & FAITHFUL PERPETUATION OF THE POSITION OF THE ORIGINAL CORNER.

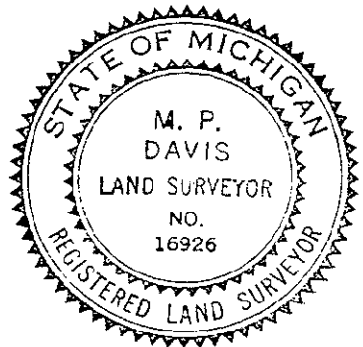

C. Description of monument for corner and accessories established to perpetuate locating the position of the corner:

- G-12 PLACED OVER EXISTING MON & 6" BELOW GRADE A 5/8"x18" REBAR W/A 3/4" ALUM CAP STAMPED TO ID THE CORNER POSITION.
5/8" X 18" REBAR W/A 2" ALUM WIT'S CAP POWER POLE SURVEY MONUMENT SIGN POST
N46"W S42"E N10"E SOUTH
30.83' 21.64' 38.44' 19.60' (TO FACE)
G-11 SET A BERNTSEN A1NB30 ALUM MON W/A 3/4" ALUM CAP STAMPED TO ID THE CORNER POSITION.
ASH 14" ASH 9" ASH 9" SURVEY MONUMENT SIGN POST NOTE: CORNER POSITION IS IN A ALDER SWP AS CALLED
N72"E S28"E S68"W N45"W FOR & RECENTLY BEEN CLEAR CUT IN ALL 4 QUADS.
26.50' 28.71' 24.44' 1.56' (TO FACE)

NOTE: BEARINGS TO REFERENCE OBJECTS ARE MAGNETIC & DISTANCES ARE TO A NAIL IN THE CENTER OF THE OBJECT, UNLESS OTHERWISE NOTED.

Signed by M.P. Davis Date 7/23/97

Surveyor's Michigan License No. 16926