

SURVEY & REMONUMENTATION

JAN 14 1998

SECTION

LAND CORNER RECORDATION CERTIFICATE
Filing Requirement of Act 74, Mich. P.A. 1970

Approved By Delta County
 Land Survey Remonumentation
 Peer Group Under Act 345 Of
 P.A. Of 1990 On 12/18, 1992
Robert Behmeling
 Acting Chairman

For corners in

DELTA

(County)

Located In:

Corner Code #

- | | | |
|------------------------------------|-----------------------------|------------------------|
| 1. Public Land Survey | T <u>41</u> N R <u>23</u> W | <u>I-10 & I-11</u> |
| | T _____ R _____ | _____ |
| | T _____ R _____ | _____ |
| | T _____ R _____ | _____ |
| 2. Property Controlling in Section | S _____ T _____ R _____ | _____ |
| | S _____ T _____ R _____ | _____ |
| 3. Miscellaneous Property in Sec. | S _____ T _____ R _____ | _____ |
| | S _____ T _____ R _____ | _____ |

Recorded DEC 19 1997
 at 9:00 am
8 252

Register of Deeds Stamp & File Number

4. Lot No. _____, Recorded Plat _____
 5. Private Claims I-10 W1/4 COR SEC 26 I-11 NW COR SEC 35

	A	B	C	D	E	F	G	H	I	J	K	L	M
2	6	5	4	3	2	1							
3													
4	7	8	9	10	11	12							
5													
6	18	17	16	15	14	13							
7													
8	19	20	21	22	23	24							
9													
10	30	29	28	27	26	25							
11													
12	31	32	33	34	35	36							
13													


I, M.P. DAVIS, in a field survey on 05 MAY, 19 97, do hereby certify that under requirements of P.A. 74, Michigan P.A. of 1970, the corner points mentioned in lines 1 and 2 above were in conformance with regulations and rules therefore as required in the current manual of survey instructions of the United States Department of the Interior, Bureau of Land Management or by a decree of a Court of Law and/or that the corner points mentioned in lines 3, 4 and 5 above were in conformance with the rules of the Michigan Board of Land Surveyors or by a Decree of a Court of Law; established, re-established, monumented, re-monumented, recovered, found as expressed below:

NOTE: Not more than 4 corners, all in the same town and range, may be recorded on this certificate.

- A. Description of original monument and accessories and/or subsequent restoration:
 I-10 [W1/4 COR SEC 26]-A.MERRYWEATHER, D.S.-1947-WOOD POST (BALSAM 04°-S34°E-05 LINKS)(CEDAR 12°-N20°W-19 LINKS)
 NO RECORD EVIDENCE OF CORNER RECOVER AND/OR SUBSEQUENT CORNER RESTORATION.
 I-11 [NW COR SEC 35]-A.MERRYWEATHER, D.S.-1847-WOOD POST (SUGAR MAPLE 10°-N25°E-17 LINKS)(SUGAR MAPLE 12°-S59°W-35 LINKS)
 J.S.CRAIG-1900-ROAD ALIGNMENT SURVEY FOR BALDWIN TWP.-ORIG'S IN PLACE-NBT'S BEECH 11°-S65°W-62.5 LINKS MAPLE 5°-N17°E-63.5 LINKS
 DELTA COUNTY RD COMM-1947-IRON IN PLACE NO WIT'S NOTED

B. Description of corner evidence found and/or method applied in restoring or reestablishing corner:
 I-10 [W1/4 COR SEC 26] NO CORNER EVIDENCE FOUND. ESTABLISHED CORNER AT MIDPOINT BETWEEN & ON LINE WITH SEC COR'S. 1/2 MILE NORTH & SOUTH AND 19' WEST OF RELATIVE NEW N-S 3 STRAND BARBED WIRE FENCE.

I-11 [NW COR SEC 35] FOUND DOZED OUT & LYING FLAT IN COUNTY RD BED A 1/2" IRON PIN. NO EVIDENCE OF CRAIG'S 1900 BT'S FOUND. REESTABLISHED CORNER POSITION IN C/L OF E-W COUNTY ROAD & AT PROPORTIONED DISTANCE BETWEEN N1/4 COR'S OF SEC'S 34 & 35, BASED ON THE 1947 MEASUREMENTS OF THE DELTA COUNTY RD COMM WHICH CHECKS VERY WELL BETWEEN THE 1/4 COR'S. ACCEPTED THIS POSITION AS BEING THE BEST AVAILABLE EVIDENCE AS TO THE LOCATION OF THE POSITION OF THE ORIGINAL CORNER.

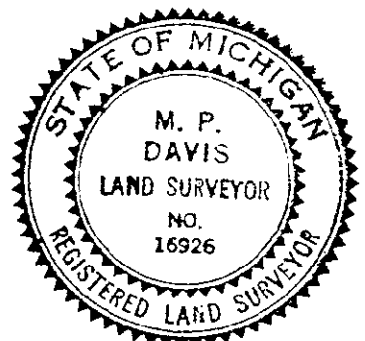

C. Description of monument for corner and accessories established to perpetuate locating the position of the corner:

I-10 SET A EERNTSEN AINB30 ALUM MON W/A 3 1/4" ALUM CAP STAMPED TO ID THE CORNER POSITION.

W.BIRCH 07°	W. BIRCH 06°	BALSAM 06°	W.BIRCH 05°	SURVEY MONUMENT SIGN POST
N64°W	N28°E	S35°E	S38°W	WEST
4.23'	16.45'	7.50'	22.86'	1.40" (TO FACE)

I-11 SET, 6" BELOW GRADE, A 5/8" X 18" REBAR W/A 3 1/4" ALUM CAP STAMPED TO ID THE CORNER POSITION.

MAPLE 9°	MAPLE 6°	MAPLE 13°	MAPLE 12°	SURVEY MONUMENT SIGN POST
N40°W	N40°E	S10°E	S37°W	NORTH
60.23'	40.65'	76.40'	81.63'	28.77' (TO FACE)

NOTE: BEARINGS TO REFERENCE OBJECTS ARE MAGNETIC & DISTANCES ARE TO A NAIL IN THE CENTER OF THE OBJECT, UNLESS OTHERWISE NOTED.

Signed by M.P. Davis 12/9/97 Date 12/9/97
 Surveyor's Michigan License No. 16926