

OCT 31 1997

COMMISSION

LAND CORNER RECORDATION CERTIFICATE
Filing Requirement of Act 74, Mich. P.A. 1970

Approved By Delta County
Land Survey Remonumentation
Peer Group Under Act 345 Of
P.A. Of 1990 On July 23, 1992
Chairman

For corners in

Form with fields for County (DELTA), Located in, Corner Code #, and survey details (Public Land Survey, Property Controlling, etc.)

28 July 1997
9:00 a.m.
8 222
Walter C. Thorne
Delta County Reg. of Deeds

Register of Deeds Stamp & File Number

4. Lot No. , Recorded Plat
5. Private Claims
K-11 NW COR SEC 36 K-13 SW COR SEC 36

Grid table with columns A-M and rows 2-13, containing numbers 1-36 and a small diagram of a corner point.

I, M.P. DAVIS, in a field survey on 05 MAY, 19 97, do hereby certify that under requirements of P.A. 74, Michigan P.A. of 1970, the corner points mentioned in lines 1 and 2 above were in conformance with regulations and rules therefore as required in the current manual of survey instructions of the United States Department of the Interior, Bureau of Land Management or by a decree of a Court of Law and/or that the corner points mentioned in lines 3, 4 and 5 above were in conformance with the rules of the Michigan Board of Land Surveyors or by a Decree of a Court of Law: established, re-established, monumented, re-monumented, recovered, found as expressed below:

NOTE: Not more than 4 corners, all in the same town and range, may be recorded on this certificate.

A. Description of original monument and accessories and/or subsequent restoration:


K-11 [NW COR SEC 36] A.MERRYWEATHER, D.S.-1847-WOOD POST (SUGAR MAPLE 12"-S25°W-42 LINKS)(BEECH 08"-N34°E-24 LINKS) J.S.CRAIG-1900-FROM ORIGINALS-NBT (SUGAR 4"-N40°W-34.5 LINKS DELTA COUNTY RD COMM-1947-COR IN PLACE -NO WIT'S NOTED

K-13 [SW COR SEC 36] JOHN BURT D.S.-1845-WOOD POST (HEMLOCK 15"-N65°W-36 LINKS)(HEMLOCK 18"-N36°E-06 LINKS) NO RECORD EVIDENCE OF CORNER RECOVERY AND/OR SUBSEQUENT CORNER RESTORATION

B. Description of corner evidence found and/or method applied in restoring or reestablishing corner:

K-11 [NW COR SEC 36] NO CORNER EVIDENCE FOUND. RESTORED CORNER POSITION ON C/L OF E-W COUNTY RD. 434 & IN LINE WITH ANCIENT FENCE & OCCUPATION LINE TO THE SOUTH. ACCEPTED THIS LOCATION AS BEING THE BEST AVAILABLE EVIDENCE AS TO THE POSITION OF THE ORIGINAL CORNER. THIS POSITION CHECKS REASONABLY WELL WITH THE DELTA COUNTY RD COMM DISTANCES TO ADJOINING CORNERS.

K-13 [SW COR SEC 36] NO CORNER EVIDENCE FOUND. ESTABLISHED CORNER POSITION ON LINE WITH AND AT A PROPORTIONATE DISTANCE BETWEEN THE SW CORNER OF SEC 35 T.41N R23W & THE SE CORNER OF SEC 31 T41N R22W. THIS POSITION FALLS IN ANCIENT E-W FENCE LINE (DOWN & IN POOR REPAIR). THE 'GLO' DISTANCE EAST TO THE ESCANABA RIVER WAS REJECT FOR CONTROL BECAUSE OF KNOWLEDGE OF THE AMOUNT OF EROSION & SCOURING OF THE RIVER BANKS THAT TAKES PLACE EACH SPRING IN THIS AREA.

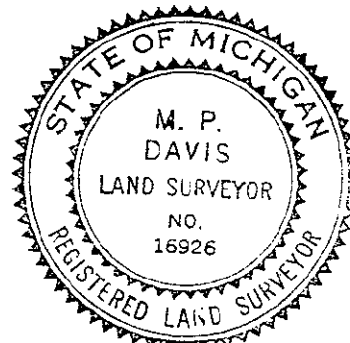

C. Description of monument for corner and accessories established to perpetuate locating the position of the corner:

K-11 SET, 6" BELOW GRADE, A 5/8" X 18" REBAR W/A 3 1/4" ALUM CAP STAMPED TO ID THE CORNER POSITION. BASSWOOD 7" MAPLE 6" BEECH 15" BEECH 14" SURVEY MONUMENT SIGN POST N48°W N33°W S13°E S23°W NORTH 62.17' 49.00' 82.24' 73.92' 34.09' (TO FACE)

K-13 SET A BERNTSEN ALNB30 ALUM MON W/A 3 1/4" ALUM CAP STAMPED TO ID THE CORNER POSITION. CEDAR 7" CEDAR 6" CEDAR 6" CEDAR 11" SURVEY MONUMENT SIGN POST N55°W N15°E S65°E S05°W EAST 33.28' 23.51' 26.15' 19.81' 1.76' (TO FACE)

NOTE: BEARINGS TO REFERENCE OBJECTS ARE MAGNETIC & DISTANCES ARE TO A NAIL IN THE CENTER OF THE OBJECT, UNLESS OTHERWISE NOTED.

Signed by M.P. Davis Date 7/23/97

Surveyor's Michigan License No. 16926