

OCT 31 1997

COMMISSION

Approved By Delta County  
Land Survey Remonumentation  
Peer Group Under Act 345 Of  
P.A. Of 1990 On July 23, 1992

*Walter C. Thomas*  
Acting Chairman

LAND CORNER RECORDATION CERTIFICATE  
Filing Requirement of Act 74, Mich. P.A. 1970

For corners in

DELTA

(County)

Located In:

Corner Code #

- 1. Public Land Survey T 41 N R 23 W
- 2. Property Controlling in Section S T R
- 3. Miscellaneous Property in Sec. S T R

L-11 & L-13

28 July 1997

9:00 a.m.

8 223

*Walter C. Thomas*  
Delta County Reg. of Deeds

Register of Deeds Stamp & File Number

- 4. Lot No. \_\_\_\_\_, Recorded Plat \_\_\_\_\_
- 5. Private Claims L-11 N1/4 COR SEC 36 L-13 S1/4 COR SEC 36

	A	B	C	D	E	F	G	H	I	J	K	L	M
2	6	5	4	3	2	1							
3													
4	7	8	9	10	11	12							
5													
6	18	17	16	15	14	13							
7													
8	19	20	21	22	23	24							
9													
10	30	29	28	27	26	25							
11													
12	31	32	33	34	35	36							
13													

I, M.P. DAVIS, in a field survey on 27 MAY, 1997, do hereby certify that under requirements of P.A. 74, Michigan P.A. of 1970, the corner points mentioned in lines 1 and 2 above were in conformance with regulations and rules therefore as required in the current manual of survey instructions of the United States Department of the Interior, Bureau of Land Management or by a decree of a Court of Law and/or that the corner points mentioned in lines 3, 4 and 5 above were in conformance with the rules of the Michigan Board of Land Surveyors or by a Decree of a Court of Law; established, re-established, monumented, re-monumented, recovered, found as expressed below:


NOTE: Not more than 4 corners, all in the same town and range, may be recorded on this certificate.

A. Description of original monument and accessories and/or subsequent restoration:  
L-11 [N1/4 COR SEC 36] A.MERRYWEATHER, D.S.-1847-WOOD POST (HEMLOCK 14'-WEST-17 LINKS)(CEDAR 12'-S70°E-20 LINKS)  
J.S.CRAIG-1900-NO 1/4 CORNER TO BE FOUND  
DELTA COUNTY RD COMM-1947-AT FENCE LINES-NO OTHER INFORMATION GIVEN

L-13 [S1/4 COR SEC 36] JOHN BURT D.S.-1845-WOOD POST (HEMLOCK 07"-N30°W-14 LINKS)(HEMLOCK 18°-N25°E-55 LINKS)  
NO RECORD EVIDENCE OF CORNER RECOVERY AND/OR SUBSEQUENT CORNER RESTORATION

B. Description of corner evidence found and/or method applied in restoring or reestablishing corner:  
L-11 [N1/4 COR SEC 36] NO CORNER EVIDENCE FOUND. REESTABLISHED CORNER POSITION ON THE C/L OF E-W COUNTY RD 434 & IN LINE WITH ANCIENT FENCE LINES N-S. THIS POSITION IS 1.45' NORTH & 7.05' WEST OF THE MID-POINT BETWEEN SEC COR'S. DISTANCES E & W CHECK REASONABLY WELL WITH COUNTY RD RECORDS. ACCEPTED THIS POSITION AS BEING THE BEST AVAILABLE EVIDENCE AS TO THE LOCATION OF THE POSITION OF THE ORIGINAL CORNER.

L-13 [S1/4 COR SEC 36] NO CORNER EVIDENCE FOUND. REESTABLISHED THE CORNER POSITION ON LINE WITH AND EQUI-DISTANCE BETWEEN THE SEC COR'S 1/2 MILE E & W

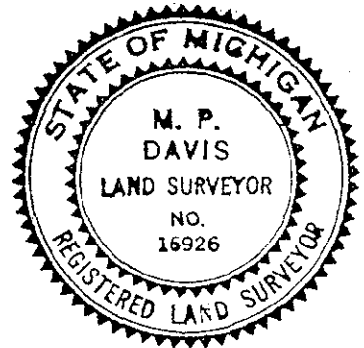

C. Description of monument for corner and accessories established to perpetuate locating the position of the corner:

L-11 SET, 6" BELOW GRADE, A 5/8" X 18" REBAR W/A 3 1/4" ALUM CAP STAMPED TO ID THE CORNER POSITION.  
CEDAR 7" MAPLE 7" CEDAR 12" POWER POLE SURVEY MONUMENT SIGN POST  
N15°W N33°E S12°E S03°W NORTE  
40.45' 43.95' 70.32' 35.75' 30.07' (TO FACE)

L-13 SET A BERNTSEN AINB30 ALUM MON W/A 3 1/4" ALUM CAP STAMPED TO ID THE CORNER POSITION.  
W.BIRCH 13" MAPLE 11" MAPLE 11" W.CHERRY 10" SURVEY MONUMENT SIGN POST  
N80°W N13°E S61°E S16°W EAST  
25.82' 10.80' 37.93' 26.78' 1.47' (TO FACE)

NOTE: BEARINGS TO REFERENCE OBJECTS ARE MAGNETIC & DISTANCES ARE TO A NAIL IN THE CENTER OF THE OBJECT, UNLESS OTHERWISE NOTED.

Signed by M.P. Davis Date 7/23/97  
Surveyor's Michigan License No. 16926