

SURVEY & REMONUMENTATION

JAN 14 1998

SECTION

LAND CORNER RECORDATION CERTIFICATE Filing Requirement of Act 74, Mich. P.A. 1970

Approved By Delta County
Land Survey Remonumentation
Peer Group Under Act 345 Of
P.A. Of 1990 On 12/18, 1992

Walter C. Thum
Acting Chairman

For corners in

DELTA

(County)

Located In:

Corner Code #

- | | | | | | |
|------------------------------------|---|---------------|-------------|--------------|-------------|
| 1. Public Land Survey | T | <u>41</u> N R | <u>23</u> W | M-10 | <u>M-12</u> |
| | T | <u>41</u> N R | <u>22</u> W | A-10 & A-12 | |
| | T | ___ R | ___ | SAME CORNERS | |
| | T | ___ R | ___ | | |
| 2. Property Controlling in Section | S | ___ T | ___ R | | |
| | S | ___ T | ___ R | | |
| 3. Miscellaneous Property in Sec. | S | ___ T | ___ R | | |
| | S | ___ T | ___ R | | |

Dec 19 1997
9:00 AM
8 288
Walter C. Thum

Register of Deeds Stamp & File Number

4. Lot No. _____, Recorded Plat _____
5. Private Claims M-10 E1/4 COR SEC 25 M-12 E1/4 COR SEC 36

A	B	C	D	E	F	G	H	I	J	K	L	M
2	6	5	4	3	2	1						
3												
4	7	8	9	10	11	12						
5												
6	18	17	16	15	14	13						
7												
8	19	20	21	22	23	24						
9												
10	30	29	28	27	26	25						
11												
12	31	32	33	34	35	36						
13												

I, M.P. DAVIS, in a field survey on 10 MARCH, 1997, do hereby certify that under requirements of P.A. 74, Michigan P.A. of 1970, the corner points mentioned in lines 1 and 2 above were in conformance with regulations and rules therefore as required in the current manual of survey instructions of the United States Department of the Interior, Bureau of Land Management or by a decree of a Court of Law and/or that the corner points mentioned in lines 3, 4 and 5 above were in conformance with the rules of the Michigan Board of Land Surveyors or by a Decree of a Court of Law; established, re-established, monumented, re-monumented, recovered, found as expressed below.

NOTE: Not more than 4 corners, all in the same town and range, may be recorded on this certificate.

A. Description of original monument and accessories and/or subsequent restoration:


M-10 [E1/4 COR SEC 25] JOHN BURT D.S.-1845-WOOD POST (B.ASH 08°-S75°W-04 LINKS)(HEMLOCK 10°-N40°W-02 LINKS) PARK SAWYER-1918-NO CORNER TO BE FOUND. ESTABLISHED ON TRUE RANGE LINE & PROPORTIONAL DISTANCE BETWEEN THE NE COR OF SEC 13 & SE CORNER OF SEC 25 T41N R23W. (W.BIRCH 11°-S14°E-8.7')(W.BIRCH 10°-N17°W-3.2')

M-12 [E1/4 COR SEC 36] JOHN BURT D.S.-1845-WOOD POST (HEMLOCK 14°-S26°W-21 LINKS)(HEMLOCK 16°-N25°W-46 LINKS) JOHN S.CRAIG-1900-NO CORNER TO BE FOUND-ESTABLISHED 1/2 DISTANCE BETWEEN CORNERS (TAM 7°-S55°E-32 LINKS)(TAM 4°-N40°W-28 LINKS)

B. Description of corner evidence found and/or method applied in restoring or reestablishing corner:

M-10 [E1/4 COR SEC 25] FOUND IN PLACE A 1 1/2" IRON PIPE, NO EVIDENCE OF PARK SAWYER'S 1918 BT'S FOUND. EXISTING MONUMENT CHECKS WELL FOR ALIGNMENT & PROPORTIONAL DISTANCE BETWEEN THE NE COR OF SEC 13 & SE COR OF SEC 25 T41N R23W. ACCEPTED EXISTING MONUMENT AS BEING A CAREFUL & FAITHFUL REESTABLISHMENT OF THE POSITION OF THE ORIGINAL CORNER.

M-12 [E1/4 COR SEC 36] NO CORNER EVIDENCE OR ACCESSORIES FOUND. CORNER POSITION FALLS IN RECENTLY CONSTRUCTED ELECTRICAL TRANSMISSION LINE CORRIDOR. PER THE RECORDS OF JOHN S. CRAIG REESTABLISHED THE CORNER POSITION ON LINE WITH & AT MIDPOINT BETWEEN SEC CORNERS 1/2 MILE NORTH & SOUTH.

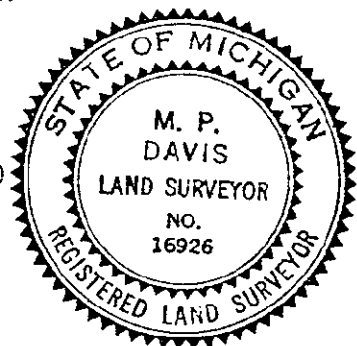

C. Description of monument for corner and accessories established to perpetuate locating the position of the corner:

M-10 SET, OVER EXISTING MONUMENT, A BERNTSEN AINB30 ALUM MONUMENT WITH THE CAP STAMPED TO ID THE CORNER POSITION.
 MAPLE 07" MAPLE 09" MAPLE 12" SURVEY MONUMENT SIGN POST
 N83°E S80°E S18°W WEST
 23.60' 14.42' 11.52' 1.56' (TO FACE)

M-12 SET A BERNTSEN AINB30 ALUM MON W/A 3 1/4" ALUM CAP STAMPED TO ID THE CORNER POSITION.
 CEDAR 10" CEDAR 07" CEDAR 05" SURVEY MONUMENT SIGN POST
 N71°E S71°E S34°E S56°W
 63.73' 52.39' 64.68' 1.79' (TO FACE)

NOTE: BEARINGS TO REFERENCE OBJECTS ARE MAGNETIC & DISTANCES ARE TO A NAIL IN THE CENTER OF THE OBJECT, UNLESS OTHERWISE NOTED.

Signed by M.P. Davis Date 12/9/97
Surveyor's Michigan License No. 16926