SURVEY &
REMONUMENTATION

NOV 1 8 1998

SECTION

INVENTORY
GLO SURVEY CORNERS
DELTA COUNTY MICHIGAN

TOTAL NO. SECTION CORNERS ESTABLISHED 48 RE ESTABLISHED 25

TOTAL NO. 1/4 CORNERS ESTABLISHED 81 RE ESTABLISHED 28

TOTAL NO. MEANDER CORNERS ESTABLISHED 22 RE ESTABLISHED 0

⬡ INDICATES M.C. NUMBERING SYSTEM
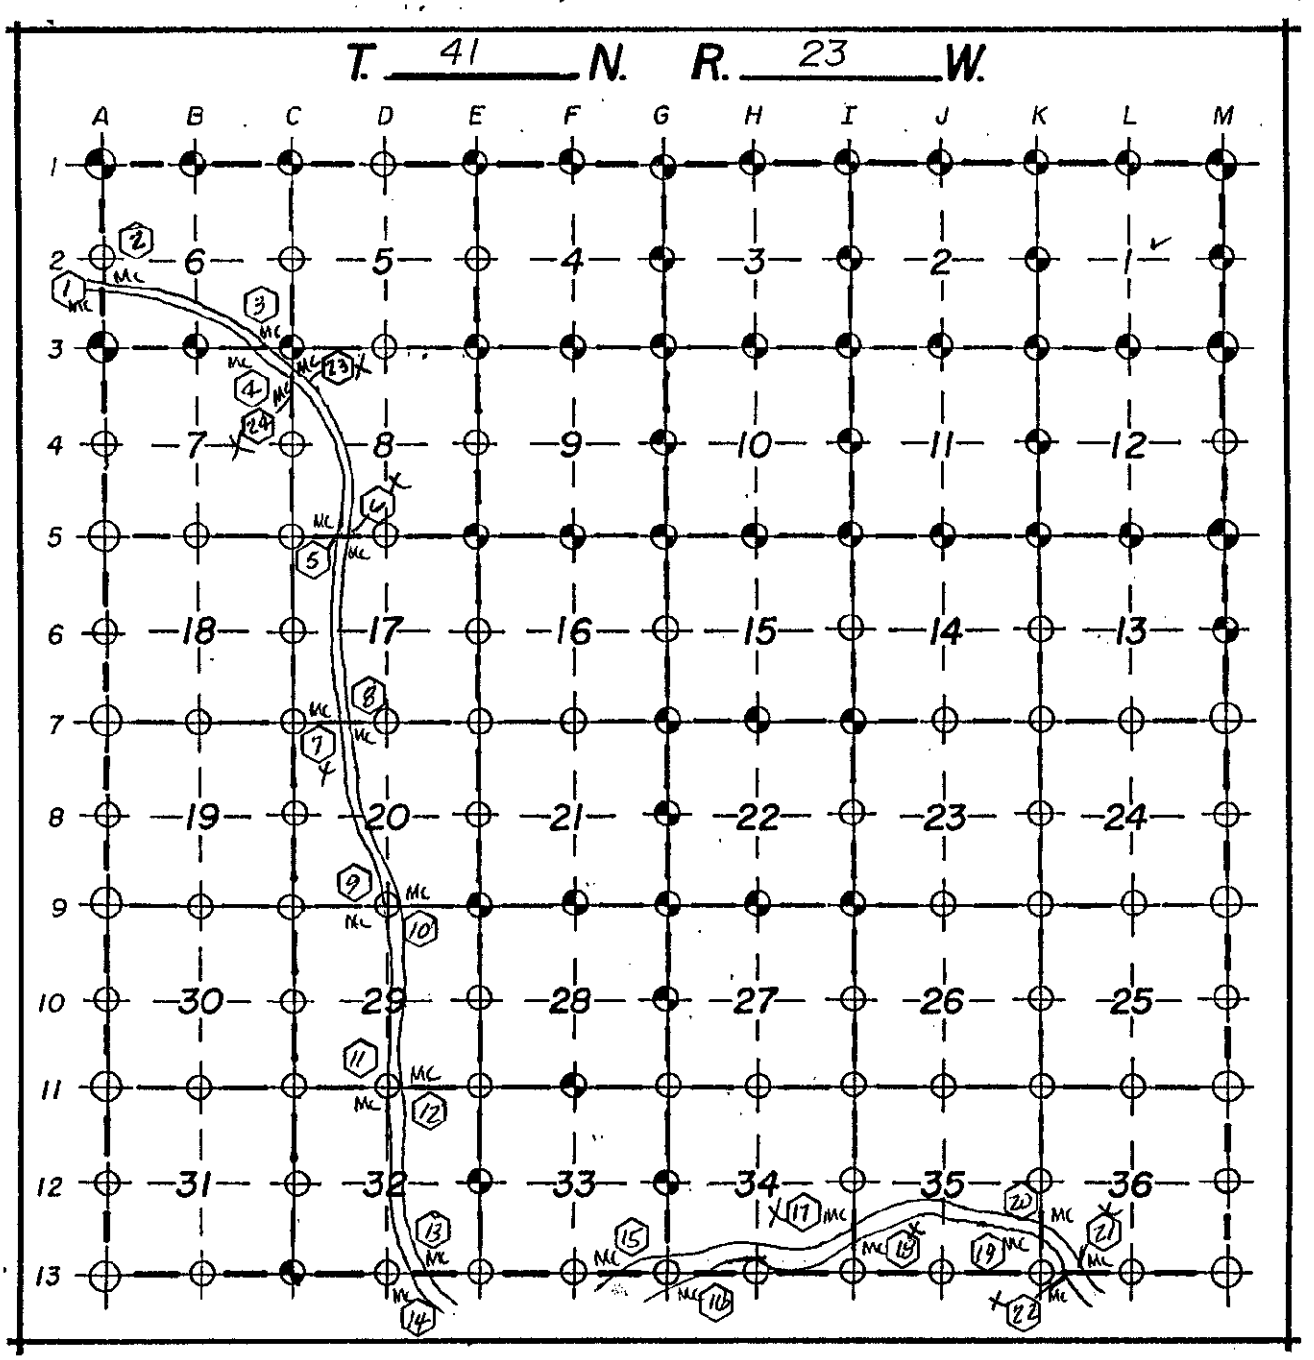
T. 41 N. R. 23 W.