

LAND CORNER RECORDATION CERTIFICATE
Filing Requirement of Act 74, Mich. P.A. 1970

For corners in

Delta (County) Located In: Corner Code #
1. Public Land Survey T 41N R 24W C-11; C-12
2. Property Controlling in Section S 32 T 41N R 24W 3
3. Miscellaneous Property in Sec. S T R

Register of Deeds Stamp & File Number

4. Lot No. Recorded Plat
5. Private Claims

I, Paul Bressette, in a field survey on December, 19 94, do hereby certify that under requirements of P.A. 74, Michigan P.A. of 1970, the corner points mentioned in lines 1 and 2 above were in conformance with regulations and rules therefor as required in the current manual of survey instructions of the United States Department of the Interior, Bureau of Land Management or by a decree of a Court of Law and/or that the corner points mentioned in lines 3, 4 and 5 above were in conformance with the rules of the Michigan Board of Land Surveyors or by a Decree of a Court of Law; established, re-established, monumented, re-monumented, recovered, found as expressed below:

NOTE: Not more than 4 corners, all in the same town and range, may be recorded on this certificate.

Grid table with columns A-M and rows 2-13. Contains numerical data and symbols (dots) at grid intersections.

A. Description of original monument and accessories and/or subsequent restoration:


- C-11. Section Corner common to Sections 29, 30, 31 and 32. 1981: Mel Davis, P.S. Replaced found wood post with ash post, no witnesses.
C-12. Quarter Corner common to Sections 31 and 32. Found old wood post shown in prior DNR survey.
3. North One-sixteenth Corner common to Sections 31 and 32. Not set in original survey. Found old wood post 1.6 feet south of monumented position.

B. Description of corner evidence found and/or method applied in restoring or reestablishing corner:

- C-11. Found wood post as described by Davis. Post was also used in previous DNR survey and was mentioned in old Sawyer-Stoll notes. Distances match fairly well in all surveys. Replaced wood post with DNR monument and witnessed.
C-12. Corner position re-established at found wood post. Post was used in prior DNR survey, and is mentioned in old Sawyer-Stoll notes as "being present a long time ago". The post is 1.0 feet off a straight line between the Northwest and Southwest corners of Section 32 and 1.65 feet from mid-point. Replaced wood post with DNR monument and witnessed.
3. Corner position established mid-point and on-line between the Northwest and West Quarter corners of Section 32.

C. Description of monument for corner and accessories established to perpetuate locating the position of the corner:

- C-11. DNR monument: 8" Ash N81E 16.8', 7" Ash S07E 17.25', 8" Ash S67W 23.75', 8" Ash N09W 30.2'
C-12. DNR monument: 3" Spruce N51E 38.05', 6" Cherry S54E 30.35', 5" Cherry S26W 61.9', 3" Spruce N04W 24.1'
3. DNR monument: 5" Cedar N82E 20.9', 10" Cedar S41E 29.05', 10" Cedar S83W 31.8', 8" Cedar N64W 53.1'

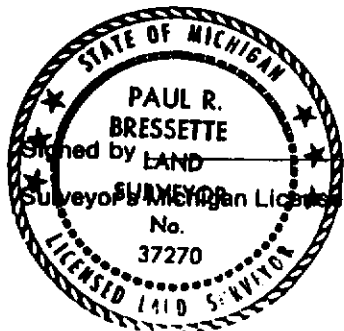

Paul R. Bressette Date

Michigan License No. 37270