

SURVEY & REMONUMENTATION

OCT 26 1995

COMMISSION

Approved By Delta County
Land Survey Remonumentation
Peer Group Under Act 345 Of
P.A. Of 1990 On Sept 27, 1995

Walter C. Thomas
Chairman

LAND CORNER RECORDATION CERTIFICATE
Filing Requirement of Act 74, Mich. P.A. 1970

For corners in
DELTA
(County)

Located In: Corner Code ##

- | | | |
|------------------------------------|-----------------------------|-----------------|
| 1. Public Land Survey | T <u>41</u> N R <u>19</u> W | <u>L-10</u> -11 |
| | T _____ R _____ | _____ |
| | T _____ R _____ | _____ |
| | T _____ R _____ | _____ |
| 2. Property Controlling in Section | S _____ T _____ R _____ | _____ |
| | S _____ T _____ R _____ | _____ |
| 3. Miscellaneous Property in Sec. | S _____ T _____ R _____ | _____ |
| | S _____ T _____ R _____ | _____ |

Recorded OCT 5 1995
at 9:00 o'clock AM in Liber 8 Page 99
Walter C. Thomas Reg. of Deeds.
Delta County, Michigan

Register of Deeds Stamp & File Number

4. Lot No. _____, Recorded Plat _____
5. Private Claims _____

L-10 [C1/4 COR SEC 25] L-11 [N1/4 COR SEC 36]

I, M.P. DAVIS, in a field survey on SEPTEMBER, 19 95, do hereby certify that under requirements of P.A. 74, Michigan P.A. of 1970, the corner points mentioned in lines 1 and 2 above were in conformance with regulations and rules therefore as required in the current manual of survey instructions of the United States Department of the Interior, Bureau of Land Management or by a decree of a Court of Law and/or that the corner points mentioned in lines 3, 4 and 5 above were in conformance with the rules of the Michigan Board of Land Surveyors or by a Decree of a Court of Law; established, re-established, monumented, re-monumented, recovered, found as expressed below:

	A	B	C	D	E	F	G	H	I	J	K	L	M
2	6	5	4	3	2	1							
3													
4	7	8	9	10	11	12							
5													
6	18	17	16	15	14	13							
7													
8	19	20	21	22	23	24							
9													
10	30	29	28	27	26	25							
11													
12	31	32	33	34	35	36							
13													

NOTE: Not more than 4 corners, all in the same town and range, may be recorded on this certificate.

A. Description of original monument and accessories and/or subsequent restoration:


L-10 [C1/4 COR SEC. 25] NOT SET IN ORIGINALS
JOSEPH E. GINGRASS - 1906 - ESTABLISHED AT INTERSECTION OF 1/4 LINES - NO WIT'S NOTED

L-11 [N1/4 COR SEC. 36] A. HERRYWEATHER, D.S. - 1849 - WOOD POST (HEMLOCK 12"-N55°E-07 LINKS) (BALSAM 06"-S60°W-08 LINKS)
JOSEPH E. GINGRASS-1906- RECORDS INDICATE CORNER IN PLACE NO OTHER INFORMATION GIVEN OR BT'S NOTED

B. Description of corner evidence found and/or method applied in restoring or reestablishing corner:

L-10 [C1/4 COR SEC 25] NO EVIDENCE OF GINGRASS'S CORNER FOUND. REESTABLISHED CORNER POSITION AT INTERSECTION OF N-S & E-W 1/4 LINES. THIS POSITION FITS WELL WITH EXISTING FARM OCCUPATION AND N-S COUNTY ROAD CONSTRUCTION.

L-11 [N1/4 COR SEC 36] NO EVIDENCE OF PREVIOUSLY MENTIONED CORNER MONUMENT FOUND AS IT HAS BEEN APPARENTLY DESTROYED IN COUNTY ROAD CONSTRUCTION. REESTABLISHED CORNER POSITION IN LINE WITH E-W FARM OCCUPATION & A PROPORTIONATE DISTANCE BETWEEN THE NE & NW CORNERS OF S36 BASED ON THE 1906 MEASUREMENTS OF GINGRASS. THIS POSITION FALLS ON A DIRECT LINE BETWEEN CORNERS E & W AND FITS WELL WITH N-S COUNTY ROAD CONSTRUCTION.

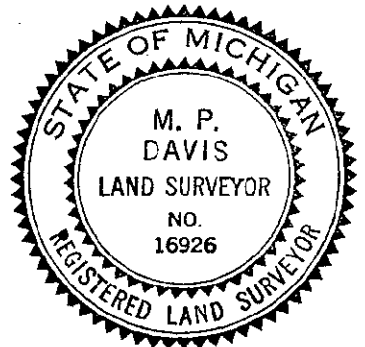

C. Description of monument for corner and accessories established to perpetuate locating the position of the corner:

L-10 SET, FLUSH WITH ROAD SURFACE, A 5/8" X 18" REBAR W/A 3 1/4" ALUMN CAP STAMPED TO ID THE CORNER POSITION.
CORNER FENCE POST WEST 31.68' (TO FACE) SURVEY MONUMENT SIGN POST EAST 28.88' (TO FACE) NOTE: CORNER POSITION SURROUNDED BY FARM FIELDS. NO OTHER WIT'S AVAILABLE.

L-11 SET, FLUSH WITH ROAD SURFACE, A 5/8" X 18" REBAR W/A 3 1/4" ALUMN CAP STAMPED TO ID THE CORNER POSITION.
5/8" IRON PIN W/A SURVEY CAP WEST 33.0' SURVEY MONUMENT SIGN POST N56°E 27.42' (TO FACE) NOTE: AREA SURROUNDED BY FARM FIELDS. NO OTHER WIT'S AVAILABLE.

NOTE: BEARINGS TO REFERENCE OBJECTS ARE MAGNETIC-DISTANCES ARE TO NAIL W/A DELTA COUNTY REFERENCE TAG, UNLESS OTHERWISE NOTED.

Signed by M.P. Davis Date 9/27/95

Surveyor's Michigan License No. 16926