

OCT 26 1995

COMMISSION

Approved By Delta County
Land Survey Remonumentation
Peer Group Under Act 345 Of
P.A. Of 1990 On Sept 22, 1995

LAND CORNER RECORDATION CERTIFICATE
Filing Requirement of Act 74, Mich. P.A. 1970

Walter S. Thum
Chairman

For corners in

DELTA

(County)

Located In:

Corner Code ##

- 1. Public Land Survey T 41 N R 19 W L-13 M-9
- T R
- T R
- T R
- 2. Property Controlling in Section S T R
- S T R
- 3. Miscellaneous Property in Sec. S T R
- S T R

Recorded OCT - 5 1995
at 9:00 o'clock AM in Liber 9 Page 100

Walter S. Thum Reg. of Deeds.
Delta County, Michigan

Register of Deeds Stamp & File Number

- 4. Lot No. _____, Recorded Plat _____
- 5. Private Claims _____

L-13 [S1/4 COR SEC 36] M-9 [NE COR SEC 25-SAME AS A-9 T41N R18W]

I, H.P. DAVIS, in a field survey on SEPTEMBER, 19 95, do hereby certify that under requirements of P.A. 74, Michigan P.A. of 1970, the corner points mentioned in lines 1 and 2 above were in conformance with regulations and rules therefore as required in the current manual of survey instructions of the United States Department of the Interior, Bureau of Land Management or by a decree of a Court of Law and/or that the corner points mentioned in lines 3, 4 and 5 above were in conformance with the rules of the Michigan Board of Land Surveyors or by a Decree of a Court of Law; established, re-established, monumented, re-monumented, recovered, found as expressed below:

NOTE: Not more than 4 corners, all in the same town and range, may be recorded on this certificate.


	A	B	C	D	E	F	G	H	I	J	K	L	M
2	6	5	4	3	2								
3													
4	7	8	9	10	11	12							
5													
6	18	17	16	15	14	13							
7													
8	19	20	21	22	23	24							
9													
10	30	29	28	27	26	25							
11													
12	31	32	33	34	35	36							
13													

A. Description of original monument and accessories and/or subsequent restoration:

- L-13 [S1/4 COR SEC. 36] JOHN BURT, D.S. - 1845 - (CEDAR 06"-N34"E-17 LINKS) (CEDAR 08"-N07"W-08 LINKS) M.S. McNABB-1920-RESTORED CORNER POSITION 331' WEST OF NE COR OF SECTION 3 T40N R19W DURING HIS SECTION SUBDIVISION OF SAID SEC 3 NO WIT'S NOTED OR DESCRIPTION OF MONUMENT GIVEN IN McNABB'S RECORDS.
- M-9 [NE COR SEC. 25] A. MERRYWEATHER, D.S. - 1848 - WOOD POST (HEMLOCK 08"-N45"E-09 LINKS) (CEDAR 14"-S56"E-12 LINKS) JOHN BURT, D.S. - 1845 - WOOD POST (Y. BIRCH-S80"W-25 LINKS) (CEDAR 14"-N18"W-22 LINKS) JOSEPH E. GINGRASS - 1906 - ID "FROM ORIGINALS" NO NEW WIT'S NOTED

B. Description of corner evidence found and/or method applied in restoring or reestablishing corner:

- L-13 [S1/4 COR SEC 36] NO EVIDENCE OF McNABB'S CORNER FOUND. REESTABLISHED CORNER POSITION ON 4TH CORRECTION LINE & 331' WEST OF NE COR SEC 3 T40N R19W. CORNER POSITION MATCHES WELL WITH COUNTY ROAD CONSTRUCTION TO THE NORTH. ACCEPTED THIS POSITION AS BEING A CAREFUL & FAITHFULL REESTABLISHMENT OF THE POSITION OF THE ORIGINAL CORNER.
- M-9 [NE COR SEC 25] NO EVIDENCE OF CORNER POSITION MENTIONED IN THE 1906 RECORDS OF GINGRASS, AS THIS AREA HAS BEEN GREATLY DISTURBED IN LOGGING OPERATIONS. RESTORED CORNER POSITION BY DISTANCE DISTANCE INTERSECT, EAST FROM THE N1/4 COR & NORTH FROM THE E1/4 COR OF SEC 25 AND BASED ON PROPORTIONATE MEASUREMENTS OF GINGRASS'S 1906 SURVEY.

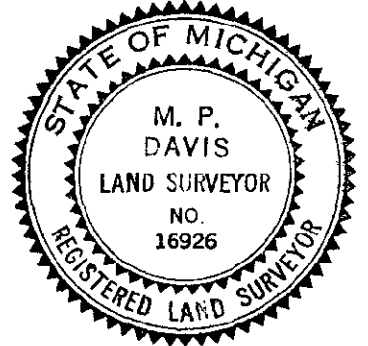

C. Description of monument for corner and accessories established to perpetuate locating the position of the corner:

- L-13 SET, 6' BELOW ROAD SURFACE, A 5/8" X 18" REBAR W/A 3 1/4" ALUMN CAP STAMPED TO ID THE CORNER POSITION.

ELM 6"	ASH 5"	COR FENCE POST	SURVEY MONUMENT SIGN POST
S54'W	N62'W	N33'E	SOUTH
40.34'	57.20'	78.10' (TO FACE)	15.04' (TO FACE)
- M-9 SET A BERNTSEN A1NB30 ALUMN MONUMENT W/A 3 1/4" ALUMN CAP STAMPED TO ID THE CORNER POSITION.

MONUMENT SIGN POST	MAPLE 6"	CEDAR 4"	NOTE: AREA HAS BEEN CLEAR CUT IN THE SE & SW QUADRANTS
EAST	N13'E	N52'W	
2.41' (TO FACE)	43.71'	54.11'	

NOTE: BEARINGS TO REFERENCE OBJECTS ARE MAGNETIC-DISTANCES ARE TO A NAIL W/A DELTA COUNTY REFERENCE TAG, UNLESS OTHERWISE NOTED.

Signed by M.P. Davis Date 9/27/95

Surveyor's Michigan License No. 16926