

# SURVEY & REMONUMENTATION

JAN 14 1998

SECTION \_\_\_\_\_

## LAND CORNER RECORDATION CERTIFICATE

Filing Requirement of Act 74, Mich. P.A. 1970

Approved By Delta County  
Land Survey Remonumentation  
Peer Group Under Act 345 Of  
P.A. Of 1990 On 12/18, 1992  
*Walter C. Thoren*  
Acting Chairman

For corners in  
DELTA  
(County)

Located In: \_\_\_\_\_ Corner Code # \_\_\_\_\_

1. Public Land Survey	T	42	NR	22	W	A-09 & A-10
	T	42	NR	23	W	M-09 & M-10
	T		R			
	T		R			
2. Property Controlling in Section	S		T		R	
	S		T		R	
3. Miscellaneous Property in Sec.	S		T		R	
	S		T		R	

Dec 19 1997  
9:00 AM  
8 284  
*Walter C. Thoren*  
Acting Chairman

Register of Deeds Stamp & File Number

4. Lot No. \_\_\_\_\_, Recorded Plat \_\_\_\_\_
5. Private Claims \_\_\_\_\_  
A-09 [NW SEC 30] A-10 [W1/4 SEC 30] SAME CORNERS AS M-09, M-10

	A	B	C	D	E	F	G	H	I	J	K	L	M
2	6	5	4	3	2	1							
3													
4	7	8	9	10	11	12							
5													
6	18	17	16	15	14	13							
7													
8	19	20	21	22	23	24							
9													
10	30	29	28	27	26	25							
11													
12	31	32	33	34	35	36							
13													

I, M.P. DAVIS, in a field survey on OCTOBER, 19 97, do hereby certify that under requirements of P.A. 74, Michigan P.A. of 1970, the corner points mentioned in lines 1 and 2 above were in conformance with regulations and rules therefore as required in the current manual of survey instructions of the United States Department of the Interior, Bureau of Land Management or by a decree of a Court of Law and/or that the corner points mentioned in lines 3, 4 and 5 above were in conformance with the rules of the Michigan Board of Land Surveyors or by a Decree of a Court of Law; established, re-established, monumented, re-monumented, recovered, found as expressed below:


**NOTE: Not more than 4 corners, all in the same town and range, may be recorded on this certificate.**

A. Description of original monument and accessories and/or subsequent restoration:  
A-09 [NW COR SEC 30] JOHN BURT, DS - 1845 - WOOD POST - (Y.BIRCH 10"-S18"W-35 LINKS)(Y.BIRCH 10"-N27"W 19 LINKS)  
E.C.MARTIN, DS - 1852 - (CEDAR 06"-S36"E-14 LINKS) FROM SURVEY OF T42N R22W  
E.C.MARTIN, DS - 1852 - (CEDAR 10"-S46"W-16 LINKS) FROM SURVEY OF T42N R23W  
NO RECORD EVIDENCE OF CORNER RECOVERY AND/OR SUBSEQUENT CORNER MONUMENTATION.

A-10 [W1/4 COR SEC 30] JOHN BURT DS - 1845 - (CEDAR 05"-S28"W-20 LINKS)(FIR 10"-N33"W-07 LINKS)  
NO RECORD EVIDENCE OF CORNER RECOVERY AND/OR SUBSEQUENT MONUMENTATION

B. Description of corner evidence found and/or method applied in restoring or reestablishing corner:  
A-09 [NW COR SEC 30] NO CORNER EVIDENCE FOUND. REESTABLISHED CORNER POSITION BY SINGLE PROPORTIONAL DISTANCE BETWEEN & ON LINE WITH THE NW CORNER OF SECTION 6 & THE NW CORNER OF SECTION 31 T42N R22W., WHICH FALLS 31' SOUTH & 30' EAST OF AN EXISTING STEEL FENCE POST. \*GLO\* TERRAIN CALL OF 1 CHAIN SOUTH TO THE EDGE OF A SWAMP FITS VERY WELL.

A-10 [W1/4 COR SEC 30] NO CORNER EVIDENCE FOUND. ESTABLISHED CORNER POSITION ON LINE WITH AND AT MIDPOINT BETWEEN SECTION CORNERS 1/2 MILE NORTH & SOUTH, WHICH FALLS 41.4' SOUTH & 69' EAST OF AN OLD FENCE CORNER, DOWN & IN POOR REPAIR.

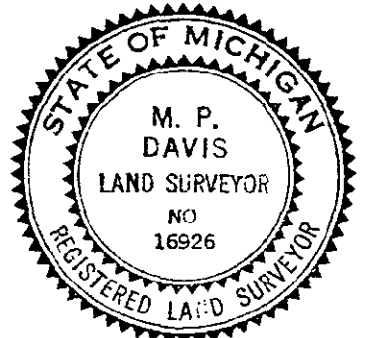

C. Description of monument for corner and accessories established to perpetuate locating the position of the corner:

A-09 SET A BERNTSEN A1NB30 ALUM MONUMENT WITH THE CAP STAMPED TO ID THE CORNER POSITION.  
CEDAR 11" CEDAR 05" CEDAR 11" CEDAR 14" SURVEY MONUMENT SIGN POST  
N67°W N55°E S62°E S05°W NORTH  
25.03' 18.83' 42.42' 3.75' 1.93' (TO FACE)

A-10 SET A BERNTSEN A1NB30 ALUM MONUMENT WITH THE CAP STAMPED TO ID THE CORNER POSITION.  
W.CHERRY 08" W.CHERRY 08" W.CHERRY 07" SURVEY MONUMENT SIGN POST  
N26°E S07°E S75°W N45°W  
26.37' 28.74' 29.15' 1.68' (TO FACE)

NOTE: BEARINGS TO REFERENCE OBJECTS ARE MAGNETIC & DISTANCES ARE TO A NAIL W/A REFERENCE TAG UNLESS OTHERWISE NOTED.

Signed by M.P. Davis Date 11/24/97

Surveyor's Michigan License No. 16926