

# SURVEY & REMONUMENTATION

JAN 14 1998

## SECTION

### LAND CORNER RECORDATION CERTIFICATE Filing Requirement of Act 74, Mich. P.A. 1970

Approved By Delta County  
Land Survey Remonumentation  
Peer Group Under Act 345 Of  
P.A. Of 1990 On 12/18, 1992

*Shelley Schmelevy*  
Acting Chairman

For corners in

DELTA  
(County)

Located In:

Corner Code #

- |                                    |   |             |   |             |                  |
|------------------------------------|---|-------------|---|-------------|------------------|
| 1. Public Land Survey              | T | <u>42 N</u> | R | <u>22 W</u> | <u>E-11</u> E-12 |
|                                    | T |             | R |             |                  |
|                                    | T |             | R |             |                  |
|                                    | T |             | R |             |                  |
| 2. Property Controlling in Section | S |             | T | R           |                  |
|                                    | S |             | T | R           |                  |
| 3. Miscellaneous Property in Sec.  | S |             | T | R           |                  |
|                                    | S |             | T | R           |                  |

Recorded Dec 19 1997  
at 9:00 AM  
by B. J. ...  
*[Signature]*

Register of Deeds Stamp & File Number

4. Lot No. \_\_\_\_\_, Recorded Plat \_\_\_\_\_  
5. Private Claims E-11 [NW SEC 33] E-12 [W1/4 SEC 33]

| A  | B  | C  | D  | E  | F  | G  | H | I | J | K | L | M |
|----|----|----|----|----|----|----|---|---|---|---|---|---|
| 2  | 6  | 5  | 4  | 3  | 2  | 1  |   |   |   |   |   |   |
| 3  |    |    |    |    |    |    |   |   |   |   |   |   |
| 4  | 7  | 8  | 9  | 10 | 11 | 12 |   |   |   |   |   |   |
| 5  |    |    |    |    |    |    |   |   |   |   |   |   |
| 6  | 18 | 17 | 16 | 15 | 14 | 13 |   |   |   |   |   |   |
| 7  |    |    |    |    |    |    |   |   |   |   |   |   |
| 8  | 19 | 20 | 21 | 22 | 23 | 24 |   |   |   |   |   |   |
| 9  |    |    |    |    |    |    |   |   |   |   |   |   |
| 10 | 30 | 29 | 28 | 27 | 26 | 25 |   |   |   |   |   |   |
| 11 |    |    |    |    |    |    |   |   |   |   |   |   |
| 12 | 31 | 32 | 33 | 34 | 35 | 36 |   |   |   |   |   |   |
| 13 |    |    |    |    |    |    |   |   |   |   |   |   |

I, M.P. DAVIS, in a field survey on DECEMBER, 19 97, do hereby certify that under requirements of P.A. 74, Michigan P.A. of 1970, the corner points mentioned in lines 1 and 2 above were in conformance with regulations and rules therefore as required in the current manual of survey instructions of the United States Department of the Interior, Bureau of Land Management or by a decree of a Court of Law and/or that the corner points mentioned in lines 3, 4 and 5 above were in conformance with the rules of the Michigan Board of Land Surveyors or by a Decree of a Court of Law; established, re-established, monumented, re-monumented, recovered, found as expressed below:


**NOTE: Not more than 4 corners, all in the same town and range, may be recorded on this certificate.**

A. Description of original monument and accessories and/or subsequent restoration:

- E-11 [NW COR SEC 33] E.C.MARTIN, DS - 1852 - WOOD POST - (CEDAR 08"-S25°E-17 LINKS)(CEDAR 12"-N45°W 04 LINKS)  
D.A.BROTHERTON-1910-FOR TWP. ROAD-ID CORNER POSITION BY OLD BT STAKES IN PLACE NE & SW 33'- SET IRON
- E-12 [W1/4 COR SEC 33] E.C.MARTIN DS - 1852 - (MAPLE 08"-S54°E-13 LINKS)(CEDAR 12"-N54°W-37 LINKS)  
D.A.BROTHERTON-1919-FOR TWP. ROAD-ID CORNER POSITION BY STAKE IN HWY & OLD BT STAKES NE & SW 33'-SET IRON,  
CORNER FENCE POST S89°E-29'

B. Description of corner evidence found and/or method applied in restoring or reestablishing corner:

- E-11 [NW COR SEC 33] FOUND IN PLACE & 12" M/L BELOW ROAD SURFACE A 5/8" IRON PIN AT APPROX. C/L INTERSECTION OF COUNTY ROAD N-S & E & W. NO ACCESSORIES FOUND. ACCEPTED EXISTING MONUMENT AS BEING THE BEST AVAILABLE EVIDENCE AS TO THE LOCATION OF THE POSITION OF THE ORIGINAL CORNER.
- E-12 [W1/4 COR SEC 33] FOUND IN PLACE & 20" M/L BELOW ROAD SURFACE A 5/8" IRON BAR IN LINE WITH OLD FENCE LINE TO THE EAST. BEARING & DISTANCE CHECKS WELL FROM EXISTING MONUMENT TO THE CORNER FENCE POST (NOW DOWN & IN POOR CONDITION) WITH THAT SHOWN IN THE RECORDS OF BROTHERTON. ACCEPTED EXISTING MONUMENT AS BEING THE BEST AVAILABLE EVIDENCE AS TO THE LOCATION OF THE POSITION OF THE ORIGINAL CORNER.

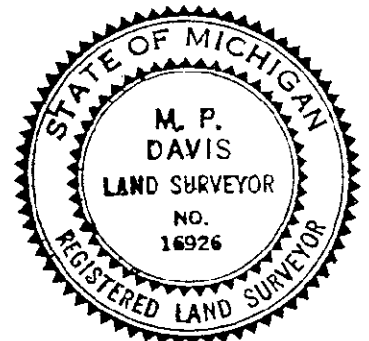

C. Description of monument for corner and accessories established to perpetuate locating the position of the corner:

- E-11 SET, OVER EXISTING MON, A 5/8 X 18" REBAR W/A 3 1/4" ALUM CAP STAMPED TO ID THE CORNER POSITION & RAISED TO GRADE W/A MON BOX  
CEDAR 04" CUT NOTCH-NORTH END CMP CUT NOTCH-SOUTH END CMP SURVEY MONUMENT SIGN POST  
N64°E N56°W S61°W S53°E  
54.65' 29.70' 28.60' 38.15' (TO FACE)
- E-12 SET, OVER EXISTING MON, A 5/8 X 18" REBAR W/A 3 1/4" ALUM CAP STAMPED TO ID THE CORNER POSITION & RAISED TO GRADE W/A MON BOX  
ELM 03" TAMARACK 03" TAMARACK 09" SURVEY MONUMENT SIGN POST  
S17°E N51°E N78°W S85°E  
78.19' 38.26' 63.10' 27.97' (TO FACE)

NOTE: BEARINGS TO REFERENCE OBJECTS ARE MAGNETIC & DISTANCES ARE TO A NAIL W/A REFERENCE TAG UNLESS OTHERWISE NOTED.

Signed by M.P. Davis Date 12/9/97  
Surveyor's Michigan License No. 16926