

SURVEY & REMONUMENTATION

JAN 14 1998

SECTION

LAND CORNER RECORDATION CERTIFICATE
Filing Requirement of Act 74, Mich. P.A. 1970

Approved By Delta County
 Land Survey Remonumentation
 Peer Group Under Act 345 Of
 P.A. Of 1990 On 12/18, 1992
Robert Schmeling
 Chairman

For corners in
DELTA
 (County)

Located In: Corner Code #

1. Public Land Survey	T	<u>42</u> N	R	<u>22</u> W	<u>G-09 & G-10</u>
	T		R		
	T		R		
	T		R		
2. Property Controlling in Section	S		T	R	
	S		T	R	
3. Miscellaneous Property in Sec.	S		T	R	
	S		T	R	

Dec 19 1997
9:00 AM
8:269
Robert C. Thum

Register of Deeds Stamp & File Number

4. Lot No. _____, Recorded Plat _____
 5. Private Claims G-09 [NW SEC 27] G-10 [W1/4 SEC 27]


A	B	C	D	E	F	G	H	I	J	K	L	M
2	6	5	4	3	2	1						
3												
4	7	8	9	10	11	12						
5												
6	18	17	16	15	14	13						
7												
8	19	20	21	22	23	24						
9												
10	30	29	28	27	26	25						
11												
12	31	32	33	34	35	36						
13												

I, M.P. DAVIS, in a field survey on NOVEMBER, 19 97, do hereby certify that under requirements of P.A. 74, Michigan P.A. of 1970, the corner points mentioned in lines 1 and 2 above were in conformance with regulations and rules therefore as required in the current manual of survey instructions of the United States Department of the Interior, Bureau of Land Management or by a decree of a Court of Law and/or that the corner points mentioned in lines 3, 4 and 5 above were in conformance with the rules of the Michigan Board of Land Surveyors or by a Decree of a Court of Law; established, re-established, monumented, re-monumented, recovered, found as expressed below:

NOTE: Not more than 4 corners, all in the same town and range, may be recorded on this certificate.

- A. Description of original monument and accessories and/or subsequent restoration:
 G-09 [NW COR SEC 27] .C.MARTIN, DS - 1852 - WOOD POST - (Y.BIRCH 12"-S73°W-39 LINKS){BLACK ASH 12"-N25°E 32 LINKS)
 D.A.BROTHERTON-1910-FOR TWP. ROAD-ID CORNER BY OLD STAKE & BT STAKE SW-SET NEW BT STAKES NE & SW 33'
 G-10 [W1/4 COR SEC 27] E.C.MARTIN DS - 1852 - (SUGAR 12"-S74°E-17 LINKS){FIR 10"-N24°W-26 LINKS)
 D.A.BROTHERTON-1919-FOR TWP. ROAD-ID CORNER BY OLD BT STAKES NW & SE 33,' NO NEW WIT'S NOTED

- B. Description of corner evidence found and/or method applied in restoring or reestablishing corner:
 G-09 [NW COR SEC 27] FOUND IN PLACE & 20" M/L BELOW ROAD SURFACE AN IRON BOLT IN LINE WITH AN ANCIENT FENCE LINE TO THE WEST (DOWN & IN POOR REPAIR). NO EVIDENCE OF BROTHERTON'S BT STAKES TO BE FOUND. ACCEPTED EXISTING MONUMENT AS BEING THE BEST AVAILABLE EVIDENCE AS TO THE LOCATION OF THE POSITION OF THE ORIGINAL CORNER.
 G-10 [W1/4 COR SEC 27] FOUND IN PLACE & 10" M/L BELOW ROAD SURFACE AN IRON BOLT IN LINE WITH AN ANCIENT FENCE LINE TO THE EAST (DOWN & IN POOR CONDITION). DISTANCE NORTH 1/2 MILE CHECKS WELL WITH THE RECORDS OF BROTHERTON & THE SPLIT OF THE 1/2 MILE FITS WITH AN OLD FENCE LINE TO THE EAST AT THE 1/16 CORNER POSITION. ACCEPTED EXISTING MONUMENT AS BEING BEST AVAILABLE EVIDENCE AS TO THE LOCATION OF THE POSITION OF THE ORIGINAL CORNER.

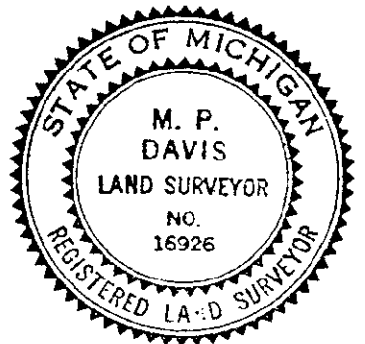

- C. Description of monument for corner and accessories established to perpetuate locating the position of the corner:
 G-09 SET, OVER EXISTING MON & 6" M/L BELOW GRADE, A 5/8 X 18" REBAR W/A 3 1/4" ALUM CAP STAMPED TO ID THE CORNER POSITION.
 CEDAR 14" MAPLE 07" W.BIRCH 08" Y.BIRCH 10" SURVEY MONUMENT SIGN POST
 S54°W S37°E N68°E S79°W N70°W
 45.65' 57.90' 22.75' 42.50 24.65' (TO FACE)
 G-10 SET, OVER EXISTING MON & 6" M/L BELOW GRADE, A 5/8 X 18" REBAR W/A 3 1/4" ALUM CAP STAMPED TO ID THE CORNER POSITION.
 SPRUCE 06" SPRUCE 06" DRILL HOLE IN STONE 5/8 X 18" REBAR W/A 2" ALUM REF CAP SURVEY MONUMENT SIGN POST
 N53°E S58°E N23°W S42°W WEST
 28.68' 35.58' 69.10' 20.22' 21.20' (TO FACE)

NOTE: BEARINGS TO REFERENCE OBJECTS ARE MAGNETIC & DISTANCES ARE TO A NAIL W/A REFERENCE TAG UNLESS OTHERWISE NOTED.

Signed by M.P. Davis Date 11/28/97
 Surveyor's Michigan License No. 16926