

**SURVEY &  
REMONUMENTATION**

**JAN 14 1998**

**SECTION**

**LAND CORNER RECORDATION CERTIFICATE**  
Filing Requirement of Act 74, Mich. P.A. 1970

Approved By Delta County  
Land Survey Remonumentation  
Peer Group Under Act 345 Of  
P.A. Of 1990 On 12/18, 1992  
*Phyllis Schumling*  
acting Chairman

For corners in

DELTA  
(County)

Located In:

Corner Code ##

- |                                       |                             |                           |
|---------------------------------------|-----------------------------|---------------------------|
| 1. Public Land Survey                 | T <u>42</u> N R <u>22</u> W | <u>G-11</u> & <u>G-12</u> |
|                                       | T _____ R _____             | _____                     |
|                                       | T _____ R _____             | _____                     |
|                                       | T _____ R _____             | _____                     |
| 2. Property Controlling<br>in Section | S _____ T _____ R _____     | _____                     |
|                                       | S _____ T _____ R _____     | _____                     |
| 3. Miscellaneous<br>Property in Sec.  | S _____ T _____ R _____     | _____                     |
|                                       | S _____ T _____ R _____     | _____                     |

Dec 19 1997  
9:00 AM  
8 270

Register of Deeds Stamp & File Number

4. Lot No. \_\_\_\_\_, Recorded Plat \_\_\_\_\_
5. Private Claims \_\_\_\_\_  
G-11 [NW SEC 34] G-12 [W1/4 SEC 34]

	A	B	C	D	E	F	G	H	I	J	K	L	M
2	6	5	4	3	2	1							
3													
4	7	8	9	10	11	12							
5													
6	18	17	16	15	14	13							
7													
8	19	20	21	22	23	24							
9													
10	30	29	28	27	26	25							
11													
12	31	32	33	34	35	36							
13													

I, M.P. DAVIS, in a field survey on NOVEMBER, 19 97, do hereby certify that under requirements of P.A. 74, Michigan P.A. of 1970, the corner points mentioned in lines 1 and 2 above were in conformance with regulations and rules therefore as required in the current manual of survey instructions of the United States Department of the Interior, Bureau of Land Management or by a decree of a Court of Law and/or that the corner points mentioned in lines 3, 4 and 5 above were in conformance with the rules of the Michigan Board of Land Surveyors or by a Decree of a Court of Law; established, re-established, monumented, re-monumented, recovered, found as expressed below:


**NOTE: Not more than 4 corners, all in the same town and range, may be recorded on this certificate.**

**A. Description of original monument and accessories and/or subsequent restoration:**

- G-11 [NW COR SEC 34] C.MARTIN, DS - 1852 - WOOD POST - (TAMARACK 30"-S66°W-47 LINKS)(CEDAR 16"-N40°E 26 LINKS)  
D.A.BROTHERTON-1910-FOR TWP. ROAD-ID CORNER BY OLD STAKE & BT STAKES NW 31' & SE 35'-SET IRON BOLT NO NEW WIT'S NOTED.
- G-12 [W1/4 COR SEC 34] E.C.MARTIN DS - 1852 - (CEDAR 14"-S71°W-18 LINKS)(CEDAR 12"-N18°E-17 LINKS)  
D.A.BROTHERTON-1919-FOR TWP. ROAD-ID CORNER BY OLD BT STAKES NW & SE 35', SET IRON, NO NEW WIT'S NOTED

**B. Description of corner evidence found and/or method applied in restoring or reestablishing corner:**

- G-11 [NW COR SEC 34] FOUND IN PLACE & 16" M/L BELOW ROAD SURFACE AN IRON BOLT W/A HEX NUT & 18' SOUTH OF THE C/L INTERSECTION OF COUNTY ROAD N-S & E.NO EVIDENCE OF BROTHERTON'S BT STAKES TO BE FOUND. ACCEPTED EXISTING MONUMENT AS BEING THE BEST AVAILABLE EVIDENCE AS TO THE LOCATION OF THE POSITION OF THE ORIGINAL CORNER.
- G-12 [W1/4 COR SEC 34] FOUND IN PLACE & 10" M/L BELOW ROAD SURFACE AN IRON BOLT. NO OCCUPATION TO THE EAST OR WEST. 1/2 DISTANCE BETWEEN SECTION CORNERS NORTH & SOUTH 1/2 MILE FITS WELL WITH EXISTING OCCUPATION LINES AT THE 1/16 CORNERS. ACCEPTED EXISTING MONUMENT AS BEING BEST AVAILABLE EVIDENCE AS TO THE LOCATION OF THE POSITION OF THE ORIGINAL CORNER.

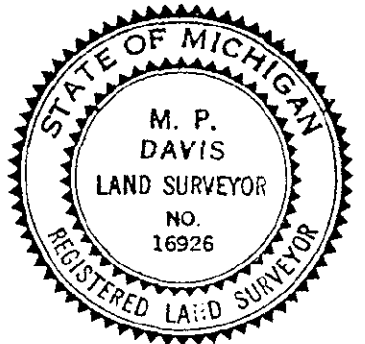

**C. Description of monument for corner and accessories established to perpetuate locating the position of the corner:**

- G-11 SET, OVER EXISTING MON, A 5/8 X 18" REBAR W/A 3 1/4" ALUM CAP STAMPED TO ID THE CORNER POSITION, RAISED TO GRADE W/A MON BOX  
CUT NOTCH ON NORTH END OF CMP SPRUCE 06" CUT NOTCH ON SOUTH END OF CMP SURVEY MONUMENT SIGN POST  
N24°W N52°E S85°W S80°E S35°E  
48.55' 52.97' 39.20' 42.05' 40.25' (TO FACE)
- G-12 SET, OVER EXISTING MON, A 5/8 X 18" REBAR W/A 3 1/4" ALUM CAP STAMPED TO ID THE CORNER POSITION & RAISED TO GRADE W/A MON BOX  
TAMARACK 06" BALSAM 05" DRILL HOLE IN STONES SURVEY MONUMENT SIGN POST  
N48°W S54°E N48°W S78°W WEST  
48.50' 29.00' 34.00' 26.90' 23.78' (TO FACE)

NOTE: BEARINGS TO REFERENCE OBJECTS ARE MAGNETIC & DISTANCES ARE TO A NAIL W/A REFERENCE TAG UNLESS OTHERWISE NOTED.

Signed by M.P. Davis Date 11/28/97  
Surveyor's Michigan License No. 16926