SURVEY & REMONUMENTATION

JAN 14 1998

SECTION

Approved By Delta County Land Survey Remonumentation Peer Group Under Act 345 Of P.A. Of 1990 On 12/18, 1992

Thos L Schmeling
acting Chairman

LAND CORNER RECORDATION CERTIFICATE

Filing Requirement of Act 74, Mich. P.A. 1970

For corners in DELTA (County)

	Located In:	Corner Code #
1. Public Land Survey	T 42 N R 22 W	I-11 & I-12
	T ___ R ___	
	T ___ R ___	
	T ___ R ___	
2. Property Controlling	S ___ T ___ R ___	
in Section	S ___ T ___ R ___	
3. Miscellaneous	S ___ T ___ R ___	
Property in Sec.	S ___ T ___ R ___	

Dec 19 1997
9:00 AM
8 271

Register of Deeds Stamp & File Number

4. Lot No. _____, Recorded Plat _____
5. Private Claims _____
I-11 [NW SEC 35] I-12 [W1/4 SEC 35]

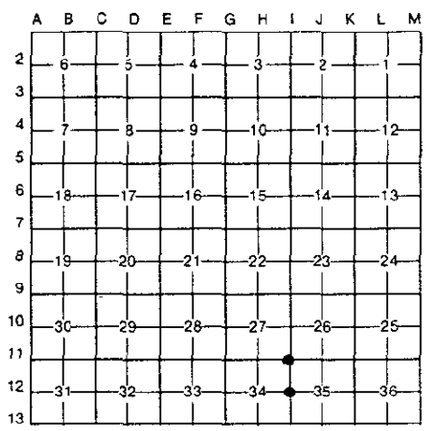

I, M.P. DAVIS, in a field survey on NOVEMBER, 19 97, do hereby certify that under requirements of P.A. 74, Michigan P.A. of 1970, the corner points mentioned in lines 1 and 2 above were in conformance with regulations and rules therefore as required in the current manual of survey instructions of the United States Department of the Interior, Bureau of Land Management or by a decree of a Court of Law and/or that the corner points mentioned in lines 3, 4 and 5 above were in conformance with the rules of the Michigan Board of Land Surveyors or by a Decree of a Court of Law; established, re-established, monumented, re-monumented, recovered, found as expressed below:

NOTE: Not more than 4 corners, all in the same town and range, may be recorded on this certificate.

A. Description of original monument and accessories and/or subsequent restoration:

I-11 [NW COR SEC 35] E.C.MARTIN, DS - 1852 - WOOD POST - (HEMLOCK 12"-S28°W-36 LINKS)(SUGAR 20"-N68°E 14 LINKS) M.S.McNABB-1917-"NO CORNER TO BE FOUND" ESTABLISHED FROM ROAD IMPROVEMENTS E-W & N, SET STONE W/A + (BIRCH STUMP 24" N42°W 26' & BT STAKE N40°E 33'

I-12 [W1/4 COR SEC 35] E.C.MARTIN DS - 1852 - (CEDAR 14"-S28°W-15 LINKS)(Y.BIRCH 12"-N60°E-15 LINKS) M.S.McNABB-1917-"NO CORNER TO BE FOUND" ESTABLISHED 1/2 DISTANCE BETWEEN CORNERS. SET BT STAKES NE & SW 33'

B. *Description of corner evidence found and/or method applied in restoring or reestablishing corner:*

I-11 [NW COR SEC 35] FOUND IN PLACE & 14" M/L BELOW ROAD SURFACE AND AT APPROXIMATE C/L INTERSECTION OF COUNTY ROADS N-S & E-W A 1" IRON PIPE, NO EVIDENCE OF McNABB'S STONE OR BT'S WAS FOUND, DISTANCE SOUTH 1 MILE TO CORRESPONDING CORNER CHECKS VERY WELL WITH THE RECORDS OF McNABB. ACCEPTED EXISTING MONUMENT AS BEING THE BEST AVAILABLE EVIDENCE AS TO THE LOCATION OF THE POSITION OF THE ORIGINAL CORNER.

I-12 [W1/4 COR SEC 35] NO CORNER EVIDENCE FOUND. REESTABLISHED CORNER POSITION ON LINE WITH AND AT MIDPOINT BETWEEN SECTION CORNERS FOUND 1/2 MILE N & S. THIS POSITION CORRESPONDS WELL WITH McNABB'S DISTANCE BETWEEN SECTION CORNER N & S, OCCUPATION LINE TO THE EAST & C/L ALIGNMENT FOR THE N-S COUNTY ROAD.

STATE OF MICHIGAN
M. P. DAVIS
LAND SURVEYOR
NO. 16926
REGISTERED LAND SURVEYOR

C. Description of monument for corner and accessories established to perpetuate locating the position of the corner:

I-11 SET, OVER EXISTING MON, A 5/8 X 18" REBAR W/A 3 1/4" ALUM CAP STAMPED TO ID THE CORNER POSITION, RAISED TO GRADE W/A MON BOX

DRILL HOLE IN LARGE FLAT STONE	STOP SIGN POST	TAMARACK 12"	MAPLE 09"
N27°W	S70°W	N53°E	S34°E
67.40'	52.20	57.76'	65.92'

I-12 SET, 6" BELOW GRADE, A 5/8 X 18" REBAR W/A 3 1/4" ALUM CAP STAMPED TO ID THE CORNER POSITION & RAISED TO GRADE W/A MON BOX

5/8" X 18" REBAR W/A 2" ALUM REF CAP		POWER POLE	POWER POLE	SURVEY MONUMENT SIGN POST
S52°W	S45°E	N48°W	N54°E	WEST
21.54'	25.05'	38.60'	55.00'	25.25' (TO FACE)

NOTE: BEARINGS TO REFERENCE OBJECTS ARE MAGNETIC & DISTANCES ARE TO A NAIL W/A REFERENCE TAG UNLESS OTHERWISE NOTED.

Signed by M.P. Davis Date 11/28/97

Surveyor's Michigan License No. 16926

FORM APPROVED BY MICHIGAN STATE BOARD OF LAND SURVEYORS, JAN. 28, 1971
REVISED MAY 14, 1975
REVISED JAN., 1983