1. Public Land Survey — T 42N R 22W — C-8, E-8
T 42N R 22W — E-7.
T ___ R ___
T ___ R ___

2. Property Controlling in Section — S ___ T ___ R ___
S ___ T ___ R ___

3. Miscellaneous Property in Sec. — S ___ T ___ R ___
S ___ T ___ R ___

DELTA CO.

Register of Deeds Stamp & File Number

4. Lot No. _____, Recorded Plat _____

5. Private Claims _____

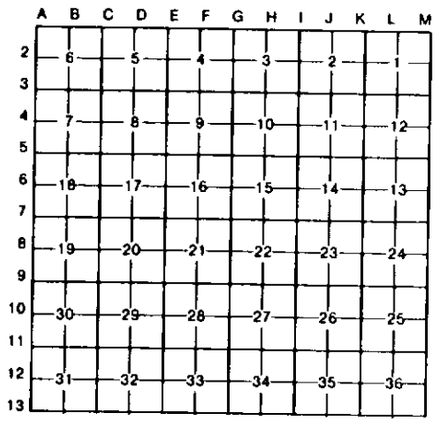

I, David Babbitt, in a field survey on 10/7&9, 19 85, do hereby certify that under requirements of P.A. 74, Michigan P.A. of 1970, the corner points mentioned in lines 1 and 2 above were in conformance with regulations and rules therefore as required in the current manual of survey instructions of the United States Department of the Interior, Bureau of Land Management or by a decree of a Court of Law and/or that the corner points mentioned in lines 3, 4 and 5 above were in conformance with the rules of the Michigan Board of Land Surveyors or by a Decree of a Court of Law; established, re-established, monumented, re-monumented, recovered, found as expressed below:

NOTE: Not more than 4 corners, all in the same town and range, may be recorded on this certificate.

A. Description of original monument and accessories and/or subsequent restoration:

C-8. West 1/4 cor. of Section 20. Wood post. Y. Birch 6 - S40E 22 Lks.
Y. Birch 12 - N57W 10 Lks.

E-8. East 1/4 cor. of Section 20. Woos post. Cedar 10" S34°E 26 Lks.
Hemlock 18" N40°W 36 Lks.

E-7. Southeast corner of Section 17. Wood post. Cedar 14" S20°W 12 Lks.
Cedar 18" N32°E 10 Lks.

B. Description of corner evidence found and/or method applied in restoring or reestablishing corner:

C-8. Set Mon. at very old corner fence post--fences E-W&S. Most posts down and rotted away. No sign of O.B.T.'s measurements north-south and east are all reasonable.

E-8. Set in ℄ of N-S County Road and in line with very old fence west. Fits very well with the original Gov't. survey record to a stream 304 ft. north.

E-7. Set in ℄ of N-S County Road and in line with very old fence east. Fits well with original Gov't. survey record for stream calls N-S & E. O.B.T.'s would have been in the road.

C. Description of monument for corner and accessories established to perpetuate locating the position of the corner:

C-8. D.N.R. Monument 8" Maple S22°W - 10.05' 5" Maple N70°E 47.4'
6" Maple N24°E - 26.9' 5" Maple N78°W 10.35'

E-8. D.N.R. Monument 12" Sugar Maple S43°E 49.0' 12" Sugar Maple S41°W 81.9'
5" Sugar Maple N55°E 46.6' 5" Sugar Maple S74°W 73.6'

E-7. D.N.R. Monument 14" Sugar Maple S70°E 81.7' 4" W. Birch N65°W 33.1'
12" Aspen S37°W 39.5' 9" Cedar Fence Post N37°E 44.65'

Signed by David B. Babbitt Date 2-11-86

Surveyor's Michigan License No. RLS 21558

FORM APPROVED BY MICHIGAN STATE BOARD OF LAND SURVEYORS, JAN 28 1971