LAND CORNER RECORDATION CERTIFICATE Filing Requirement of Act 74, Mich. P.A. 1970

Fo	r corners in			
	Delta (County)		Located In:	Corner Code ##
1.	Public Land Survey		т <u>42N</u> в <u>22W</u>	I-5, I-3
			T R	
			<u>T</u> R	
			T R	
2.	Property Controlling	S	T R	
	in Section	•	ТБ	


3. Miscellaneous


Property in Sec.

Register of Deeds Stamp & File Number

4.	Lot No	Recorded Plat	
5 .	Private Claims		

I, David Babbitt , in a field survey on _	July 1st	19 87
do hereby certify that under requirements of P.A. 74, Mich		
in lines 1 and 2 above were in conformance with regu	lations and rules there	elore as required in the
current manual of survey instructions of the United State	les Department of the	Interior, Bureau of Land
Management or by a decree of a Court of Law and/or that		
above were in conformance with the rules of the Michiga		
Court of Law; established, re-established, monumer		
expressed below:		

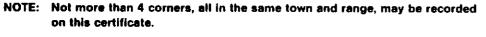

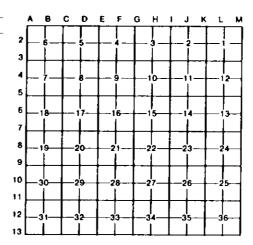

- A. Description of original monument and accessories and/or subsequent restoration:
- I-5 Southwest section corner of Section 11. Wood Post.
 - Sugar 14 S46W 35 Lks.
- I-3 Northwest section corner of Section 11. Wood Post.
- Sugar 18 N30E 8 Lks. Y. Birch 8 S39W 29 Lks. Sugar 16 - N35E - 14 Lks.
- B. Description of corner evidence found and/or method applied in restoring or reestablishing corner:
- I-5 Set by double proportion to the G.L.O. record using & corners & mile East and 2½ miles West and section corners 1 mile South and 2 miles North.
- I-3 Set by double proportion to the G.L.O. record using section corners 1 mile West, 1 mile North, 1 mile East and 2 miles South.

C. Description of monument for corner and accessories established to perpetuate locating the position of the corner:

I-5	DNR Monument		1-3	DNR Monum	ent		
9"	Sugar Maple - N63E -	- 6.55'	7"	Birch	- S36E	-	12.3'
8"	Sugar Maple - SO4E -	- 26.10'	7"	Ash	- \$36W	-	7.4'
15"	Sugar Maple - S60W -	- 43.90'	8"	Maple	- N 5W	_	24.5'
15"	Sugar Maple - N56W -	- 26.50'	11"	Basswood	- N68E	-	16.1'

Signed by _

Surveyor's Michigan License No. _

21558

FORM APPROVED BY MICHIGAN STATE BOARD OF LAND SURVEYORS, JAN. 28, 1971 REVISED MAY 14, 1975 REVISED JAN., 1943