

LAND CORNER RECORDATION CERTIFICATE
Filing Requirement of Act 74, Mich. P.A. 1970

For corners in

Delta
(County)

Located In:

Corner Code #

1. Public Land Survey

T 42N R 22W K11
T 42N R 22W K13
T R
T R

2. Property Controlling in Section

S T R
S T R

3. Miscellaneous Property in Sec.

S T R
S T R

Register of Deeds Stamp & File Number

4. Lot No. , Recorded Plat

5. Private Claims

K13 Jul 23 1997
K11 Jul 15 1997

I, Paul R. Bressette, in a field survey on 19 do hereby state that under requirements of P.A. 74, Michigan P.A. of 1970, the corner points mentioned in lines 1 and 2 above were in conformance with regulations and rules therefore as required in the current manual of survey instructions of the United States Department of the Interior, Bureau of Land Management or by a decree of a Court of Law and for that the corner points mentioned in lines 3, 4 and 5 above were in conformance with the rules of the Michigan Board of Land Surveyors or by a Decree of a Court of Law; established, re-established, monumented, recovered, found as expressed below:

NOTE: Not more than 2 corners, all in the same town and range, may be recorded on this certificate.

Grid table with columns A-L and rows 1-13. Contains numbers 1-36 and two dots in the grid.

A. Description of original monument and accessories and/or subsequent restoration:


(K11) Section corner common to Sections 25, 26, 35 and 36. 1852. E.C. Martin, D.C. Set wood post witnessed by: Cedar 12 S58E 51 lks.; Y. Birch 18 N22W 60 lks. 1909: Brotherton. SE corner Section 26 set from original Bearing Trees. No monument or witnesses given. 1937: U.S. Forest Service. Land corner record by Ray Tardiff shows corner consists of a stake, with a metal location poster on a yellow birch 22" from with this corner bears N25E 31 lks., in a hardwood slash approximately 5 chains west of Inman creek, on side of slope. Witnesses listed: Y. Birch snag 24 N40W 40 lks.; Cedar (down) 18 S13E 35 lks.; Y. Birch 22 S65W 31 lks. (K13) Section corner common to Sections 35 and 36, T42N, R22W, and Sections 1 and 2, T41N, R22W. Original GLO: Wood post witnessed by: Hemlock 14 N52E 32 lks.; Hemlock 12 N15W 15 lks. Two additional witnesses were added during subdivision of T41N, R22W: Hemlock 18 S70E 30 lks.; Hemlock 15 S44W 42 lks.

B. Description of corner evidence found and/or method applied in restoring or reestablishing corner:

(K11) Found old post at intersection of ancient fence lines south and east. Found down cedar S13E 23 feet from post, and a decayed stump S25W 20.5 feet, which match two of Tardiff's witnesses. No evidence of original bearing trees found. Measurement north to stream (rec 5.0 chains-330 feet, meas 333 feet) fits very well. Measurement east to stream (rec 4.86 chains-321 feet, meas 258 feet) fits poorly. Distance west to proportioned position of quarter corner checks fairly well with Brotherton's 1909 survey (rec 2656.4 feet, meas 2659.6 feet). Wood post appears to be at position of Forest Service stake, and the Brotherton perpetuation. Wood post was replaced with a DNR monument, and is accepted as a careful and faithful PERPETUATION of the position of the original corner. (K13) No evidence of original survey or subsequent restoration found. Found several hemlock stumps in search area, but no marks found and could not match any together for original bearing tree positions. Corner position re-established mid-point and on-line between the South quarter corner of Section 36 and the South Quarter corner of Section 35, and is accepted as a careful and faithful RE-ESTABLISHMENT of the position of the original corner.

C. Description of monument for corner and accessories established to perpetuate locating the position of the corner:

(K11) DNR monument (K13) DNR monument
07" Sugar N18E 42.2' (S25,NBT) 4" Cedar N06E 7.9' (S36,NBT)
12" Sugar S87E 12.15' (S36,NBT) 6" Cedar N74E 26.9' (S36,NBT)
06" Sugar S02W 20.2' (S35,NBT) 5" Cedar S01E 4.3' (S1,NBT)
07" Sugar N67W 44.45' (S26,NBT) 6" Cedar N83W 18.6' (S35,NBT)
All trees are blazed, scribed and painted. Measurements are to nail in side of tree, bearings are magnetic.

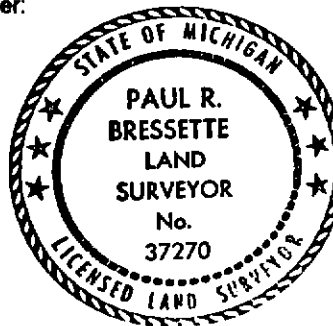

Signed by Paul R. Bressette
Surveyor's Michigan License No. 37270

Date

For the Michigan Department of Natural Resources - Forest Management Division