

LAND CORNER RECORDATION CERTIFICATE
Filing Requirement of Act 74, Mich. P.A. 1970

For corners in
Della
(County)

Located In: Corner Code #

1. Public Land Survey
T 42N R 22W K9
T _____ R _____
T _____ R _____
T _____ R _____

2. Property Controlling in Section
S 25 T 42N R 22W 4
S _____ T _____ R _____
S _____ T _____ R _____

3. Miscellaneous Property in Sec.
S _____ T _____ R _____
S _____ T _____ R _____

Register of Deeds Stamp & File Number

4. Lot No. _____, Recorded Plat _____
5. Private Claims _____

4 Jul 17 1997
K9 Jul 15 1997

I, Paul R. Bressette, in a field survey on _____, 19____ do hereby state that under requirements of P.A. 74, Michigan P.A. of 1970, the corner points mentioned in lines 1 and 2 above were in conformance with regulations and rules therefore as required in the current manual of survey instructions of the United States Department of the Interior, Bureau of Land Management or by a decree of a Court of Law and/or that the corner points mentioned in lines 3, 4 and 5 above were in conformance with the rules of the Michigan Board of Land Surveyors or by a Decree of a Court of Law; established, re-established, monumented, recovered, found as expressed below:


NOTE: Not more than 2 corners, all in the same town and range, may be recorded on this certificate.

	A	B	C	D	E	F	G	H	I	J	K	L	M
1													
2	6		5		4		3		2		1		
3													
4	7		8		9		10		11		12		
5													
6	18		17		16		15		14		13		
7													
8	19		20		21		22		23		24		
9													
10	30		29		28		27		26		25		
11													
12	31		32		33		34		35		36		
13													

A. Description of original monument and accessories and/or subsequent restoration:
(K9) Section corner common to Sections 23, 24, 25 and 26. 1852: E.C. Martin, D.S. Set wood post witnessed by: Elm 12 S84E 47 lks.; Cedar 16 N69W 26 lks. 1909: D.A. Brotherton. Set post from feature calls witnessed by: Cedar 5 N80E 2.8'; Spruce 4 N15W 2.5'. 1937: U.S. Forest Service. A land corner record by G.A. Roberts shows corner consists of cedar post, metal location poster on corner.
(4) Northwest One-sixteenth corner of Section 25. Not set in original survey, no evidence of subsequent establishment.

B. Description of corner evidence found and/or method applied in restoring or reestablishing corner:
(K9) No evidence of original survey or Brotherton's RBE's found. Did not find Forest Service location poster. Found old wood post in ancient fence line bearing east and west. Found post was smaller than fence posts and pointed on bottom. Measurements to feature call north (stream 5 Rec. 1.75 ch.-116' meas. 117'); to feature call east (stream 15 Rec. 2.62 ch.-173' meas. 174'); to feature call west (stream 5 Rec. 33.5 ch.-2211' meas. 2241') fit very well. Wood post was accepted as position of corner, replaced with DHR monument, and is accepted as the best available evidence of the position of the original corner.
(4) Corner position established at the intersection of the North and West One-sixteenth lines of Section 25.

C. Description of monument for corner and accessories established to perpetuate locating the position of the corner:
(K9) DHR monument
0" Cedar N30E 75.2' (S24,NBT)
0" Cedar S32E 51.0' (S25,NBT)
1" Cedar stub S59W 21.0' (S26,NBT)
0" Cedar stub N50W 32.55' (S23,NBT)
All trees are blazed, scribed and painted. Measurements are to nail in side of tree, bearings are magnetic.
(4) DHR monument
5" Cedar N03E 6.9' (1/16S,BT)
7" Tamarack N85E 15.7' (1/16S,BT)
9" Tamarack S40E 3.5' (1/16S,BT)
6" Cedar S86W 5.2' (1/16S,BT)
All trees are blazed, scribed and painted. Measurements are to nail in side of tree, bearings are magnetic.

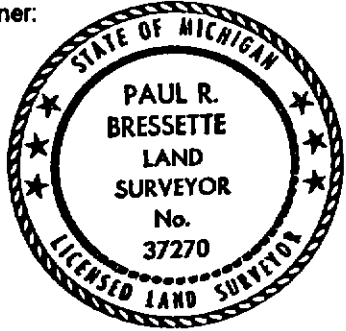

Signed by Paul R. Bressette Date _____
Surveyor's Michigan License No. 37270

For the Michigan Department of Natural Resources - Forest Management Division