

SURVEY & REMONUMENTATION

MAR 21 1997

COMMISSION

Approved by Delta County
Land Survey Remonumentation
Peer Group Under Act 345 Of

P.A. OK 1990 On 12/12, 1996

Robert J. Hinkelberg
Acting Chairman

LAND CORNER RECORDATION CERTIFICATE

Filing Requirement of Act 74, Mich. P.A. 1970

For corners in
DELTA
(County)

Located In: Corner Code #

- | | | |
|------------------------------------|-----------------------------|---------|
| 1. Public Land Survey | T <u>42</u> N R <u>23</u> W | A-5 A-6 |
| | T _____ R _____ | _____ |
| | T _____ R _____ | _____ |
| | T _____ R _____ | _____ |
| 2. Property Controlling in Section | S _____ T _____ R _____ | _____ |
| | S _____ T _____ R _____ | _____ |
| 3. Miscellaneous Property in Sec. | S _____ T _____ R _____ | _____ |
| | S _____ T _____ R _____ | _____ |

Recorded DEC 20 1996
At 2:00 o'clock PM
Book 8 Page 183
William C. Thayer
Delta County Clerk

Register of Deeds Stamp & File Number

4. Lot No. _____, Recorded Plat _____
5. Private Claims A-5 [NW COR S.18] A-6 [W1/4 COR S.18]

	A	B	C	D	E	F	G	H	I	J	K	L	M
2	6		5		4		3		2		1		
3													
4	7		8		9		10		11		12		
5													
6	18		17		16		15		14		13		
7													
8	19		20		21		22		23		24		
9													
10	30		29		28		27		26		25		
11													
12	31		32		33		34		35		36		
13													

I, M.P. DAVIS, in a field survey on 14, 22 OCTOBER, 1996, do hereby certify that under requirements of P.A. 74, Michigan P.A. of 1970, the corner points mentioned in lines 1 and 2 above were in conformance with regulations and rules therefore as required in the current manual of survey instructions of the United States Department of the Interior, Bureau of Land Management or by a decree of a Court of Law and/or that the corner points mentioned in lines 3, 4 and 5 above were in conformance with the rules of the Michigan Board of Land Surveyors or by a Decree of a Court of Law; established, re-established, monumented, re-monumented, recovered, found as expressed below:

NOTE: Not more than 4 corners, all in the same town and range, may be recorded on this certificate.

A. Description of original monument and accessories and/or subsequent restoration:


- A-5 [NW COR S.18] WILLIAM BURT, D.S. - 1841 - WOOD POST (CEDAR 18°-N80°W-15 LINKS) (B.ASH 10°-S42°E-23 LINKS)
E.C. MARTIN, D.S. - 1852 - IN PLACE (DEAD CEDAR 12°-N18°E-83 LINKS)
FROM 1852 SUBD. OF T42N R24W - DRY CEDAR 14°-S35°W-32 LINKS
D.A. BROTHERTON - 1910 - ID CORNER FROM GLO STREAM X-INGS N & S NOTED NEW BT'S (W.BIRCH 8°-S78°E-12.6') (TAMARACK 13°-N48°E-21.5')

- A-6 [W1/4 COR S.18] WILLIAM BURT, D.S. - 1841 - WOOD POST (B.ASH 12°-N14°E-12 LINKS) (CEDAR 20°-S17°W-15 LINKS)
NO RECORD EVIDENCE OF CORNER RECOVERY OR SUBSEQUENT MONUMENTATION

B. Description of corner evidence found and/or method applied in restoring or reestablishing corner:

- A-5 [NW COR S.18] FOUND IN PLACE A 1 1/4" GALV. IRON PIPE SET IN AN ANCIENT N-S FENCE LINE (DOWN & IN POOR REPAIR) NO EVIDENCE OF BROTHERTON'S 1910 WIT'S FOUND. DISTANCES N & E TO ADJOINING CORNERS CHECK REASONABLY WELL WITH BROTHERTON'S RECORDS. ACCEPTED EXISTING MONUMENT AS BEING THE BEST AVAILABLE EVIDENCE AS TO THE POSITION OF THE ORIGINAL CORNER.

- A-6 [W1/4 COR S.18] NO CORNER EVIDENCE FOUND. REESTABLISHED CORNER POSITION AT MIDPOINT BETWEEN SEC CORNERS 1/2 MILE N & S. CORNER POSITION FALLS IN LINE WITH OLD FARM FENCE FROM THE WEST.

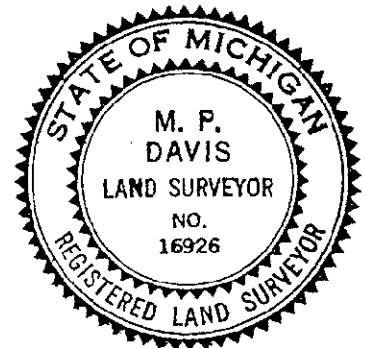

C. Description of monument for corner and accessories established to perpetuate locating the position of the corner:

- A-5 SET OVER EXISTING MON A BERNTSEN AINB30 ALUM MON WITH THE CAP STAMPED TO ID THE CORNER POSITION.

ASH 5"	ASH 10"	ASH 5"	SURVEY MONUMENT SIGN POST	WEST BANK SQUAW CREEK
N65°W	N59°E	S35°W	NORTH	EAST
39.57'	10.41'	24.90'	2.30' (TO FACE)	22'

- A-6 SET BERNTSEN AINB30 ALUM MONUMENT WITH THE CAP STAMPED TO ID THE CORNER POSITION.

ASH 12"	CEDAR 8"	ELM 6"	SURVEY MONUMENT SIGN POST	WEST BANK SQUAW CREEK
N7°E	S22°E	S54°W	NORTH	EAST
40.25'	61.48'	19.30'	3.00' (TO FACE)	23'

NOTE: BEARINGS TO REFERENCE OBJECTS ARE MAGNETIC & DISTANCES ARE TO A NAIL IN THE CENTER OF THE OBJECT, UNLESS OTHERWISE NOTED.

Signed by M.P. Davis Date 12/10/96
Surveyor's Michigan License No. 16926