

JAN 22 2000

SECTION

Approved By Delta County Land Survey Remonumentation Peer Group Under Act 345 Of P.A. Of 1990 On 12/17, 1996

Shelley Schmelzer
Chairman

LAND CORNER RECORDATION CERTIFICATE

Filing Requirement of Act 74, Mich. P.A. 1970

For corners in

DELTA

(County)

Located In:

Corner Code -#

- 1. Public Land Survey T 42 N R 23 W A-9 & A-10
T _____ R _____
T _____ R _____
T _____ R _____
- 2. Property Controlling S _____ T _____ R _____
in Section S _____ T _____ R _____
- 3. Miscellaneous S _____ T _____ R _____
Property in Sec. S _____ T _____ R _____

Recorded DEC 20 1996

at 2:00 o'clock P.M.

Liber 8 Page 185

William C. Thomas

Delta County, MI Rec. of Deeds

Register of Deeds Stamp & File Number

4. Lot No. _____, Recorded Plat _____

5. Private Claims A-9 [NW COR S.30] A-10 [W1/4 COR S.30]

A	B	C	D	E	F	G	H	I	J	K	L	M
2	6	5	4	3	2	1						
3												
4	7	8	9	10	11	2						
5												
6	18	17	16	15	14	13						
7												
8	19	20	21	22	23	24						
9												
10	30	29	28	27	26	25						
11												
12	31	32	33	34	35	36						
13												

I, M.P. DAVIS, in a field survey on 22 OCTOBER, 19 96, do hereby certify that under requirements of P.A. 74, Michigan P.A. of 1970, the corner points mentioned in lines 1 and 2 above were in conformance with regulations and rules therefore as required in the current manual of survey instructions of the United States Department of the Interior, Bureau of Land Management or by a decree of a Court of Law and/or that the corner points mentioned in lines 3, 4 and 5 above were in conformance with the rules of the Michigan Board of Land Surveyors or by a Decree of a Court of Law; established, re-established, monumented, re-monumented, recovered, found as expressed below:


NOTE: Not more than 4 corners, all in the same town and range, may be recorded on this certificate.

A. Description of original monument and accessories and/or subsequent restoration:
A-9 [NW COR S.30] WILLIAM BURT, D.S. - 1841 - WOOD POST (IRONWOOD 12"-N85°W-31 LINKS) (SUGAR 14"-S40°E-19 LINKS)
FROM 1852 SUBD OF T42N R24W - IRONWOOD 10'-S46°W-44 LINKS
NO RECORD EVIDENCE OF CORNER RECOVERY OF SUBSEQUENT MONUMENTATION

A-10 [W1/4 COR S.30] WILLIAM BURT, D.S. - 1841 - WOOD POST (HEMLOCK 14"-N45°W-11 LINKS) (Y.BIRCH 17"-S42°W-17 LINKS)
NO RECORD EVIDENCE OF CORNER RECOVERY OR SUBSEQUENT MONUMENTATION

B. Description of corner evidence found and/or method applied in restoring or reestablishing corner:
A-9 [NW COR S.30] NO CORNER EVIDENCE FOUND. ID CORNER POSITION BY JCT. OF FARM FENCES E-W & N. ACCEPTED THIS POSITION AS BEING THE BEST AVAILABLE EVIDENCE OF THE POSITION OF THE ORIGINAL CORNER.

A-10 [W1/4 COR S.30] NO CORNER EVIDENCE FOUND. ID CORNER POSITION BY JCT. OF FARM FENCES W & S. ACCEPTED THIS POSITION AS BEING THE BEST AVAILABLE EVIDENCE OF THE POSITION OF THE ORIGINAL CORNER.

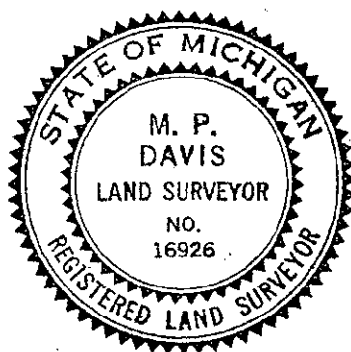

C. Description of monument for corner and accessories established to perpetuate locating the position of the corner:

A-9 SET BERNTSEN A1NB30 ALUM MONUMENT WITH THE CAP STAMPED TO ID THE CORNER POSITION.
MAPLE 12" MAPLE 09" ELM 5" SURVEY MONUMENT SIGN POST NOTE: CULTIVATED FARM FIELDS IN THE
N12°E S76°E SOUTH S45°E NW, SE & SW QUADRANTS.
28.13' 25.81' 12.90' 3.02' (TO FACE)

A-10 SET BERNTSEN A1NB30 ALUM MONUMENT WITH THE CAP STAMPED TO ID THE CORNER POSITION.
CEDAR 12' MAPLE 24" SURVEY MONUMENT SIGN POST NOTE: CULTIVATED FARM FIELDS IN THE
S32°E S25°W EAST NE & NW QUADRANTS.
33.23' 10.41' 3.00' (TO FACE)

NOTE: BEARINGS TO REFERENCE OBJECTS ARE MAGNETIC & DISTANCES ARE TO A NAIL IN THE CENTER OF THE OBJECT, UNLESS OTHERWISE NOTED.

Signed by M.P. Davis Date 12/10/96

Surveyor's Michigan License No. 16926