

# SURVEY & REMONUMENTATION

MAR 2 1 1997

COMMISSION

Approved By Delta County  
Land Survey Remonumentation  
Peer Group Under Act 345 Of

P.A. Of 1990 On 12/12, 1996

*Robert L. ...*  
Chairman

## LAND CORNER RECORDATION CERTIFICATE Filing Requirement of Act 74, Mich. P.A. 1970

For corners in

DELTA

(County)

Located In:

Corner Code #

1. Public Land Survey	T <u>42</u> N R <u>23</u> W	_____	_____	A-13
	T _____ R _____	_____	_____	
	T _____ R _____	_____	_____	
	T _____ R _____	_____	_____	
2. Property Controlling in Section	S _____ T _____ R _____	_____	_____	
	S _____ T _____ R _____	_____	_____	
3. Miscellaneous Property in Sec.	S _____ T _____ R _____	_____	_____	
	S _____ T _____ R _____	_____	_____	

Recorded DEC 20 1996

at 2:00 o'clock PM

Liber 8 Page 195

Delta County Reg. of Deeds  
**Register of Deeds Stamp & File Number**

4. Lot No. \_\_\_\_\_, Recorded Plat \_\_\_\_\_
5. Private Claims A-13 [SW COR S.31]


	A	B	C	D	E	F	G	H	I	J	K	L	M
2	6		5		4		3		2		1		
3													
4	7		8		9		10		11		12		
5													
6	13		17		16		15		14		13		
7													
8	19		20		21		22		23		24		
9													
10	30		29		28		27		26		25		
11													
12	31		32		33		34		35		36		
13													

I, M.P. DAVIS, in a field survey on 09 OCTOBER, 1996, do hereby certify that under requirements of P.A. 74, Michigan P.A. of 1970, the corner points mentioned in lines 1 and 2 above were in conformance with regulations and rules therefore as required in the current manual of survey instructions of the United States Department of the Interior, Bureau of Land Management or by a decree of a Court of Law and/or that the corner points mentioned in lines 3, 4 and 5 above were in conformance with the rules of the Michigan Board of Land Surveyors or by a Decree of a Court of Law: established, re-established, monumented, re-monumented, recovered, found as expressed below:

**NOTE: Not more than 4 corners, all in the same town and range, may be recorded on this certificate.**

A. Description of original monument and accessories and/or subsequent restoration:  
 A-13 [SW COR S.31] WILLIAM BURT, D.S. -1841 - WOOD POST (SUGAR 20°-N30°W-58 LINKS) (SUGAR 15°-S45°W-43 LINKS)  
 D.A. BROTHERTON-1912-ID COR POSITION BY SE "GLO" BT (DOWN) SET 16" IRON ROD (BALSAM 11°-N45°W-36.3') (ELM 4°-S43°E-38.8')  
 M.S. McNABB-1945-FD STAKE & IRON IN PLACE (COR FENCE POST-S45°W-41.0') (COR FENCE POST-NORTH 26') (COR FENCE POST-S45°E-41')  
 T. O'BRIEN, RLS-1977-L.2 OF LCR'S PG.165-FD 5/8" IRON BAR IN PLACE-NO WIT'S NOTED

B. Description of corner evidence found and/or method applied in restoring or reestablishing corner:  
 A-13 [SW COR S.31] FOUND IN PLACE 5/8" IRON BAR AS DESCRIBED IN LIBER 2 OF LCR'S PAGE 165. THIS MONUMENT FITS WELL WITH M.S. McNABB'S DESCRIPTION OF HIS 1945 "IRON STAKE" REPLACEMENT OF D.A. BROTHERTON'S 1912 "IRON STAKE". CORNER MONUMENT FITS WELL WITH McNABB'S DISTANCE EAST TO ADJOINING CORNERS AND BROTHERTON'S MEASUREMENTS TO THE NORTH. ACCEPTED EXISTING MONUMENT AS BEING CAREFUL & FAITHFUL PERPETUATION OF THE POSITION OF THE ORIGINAL CORNER.

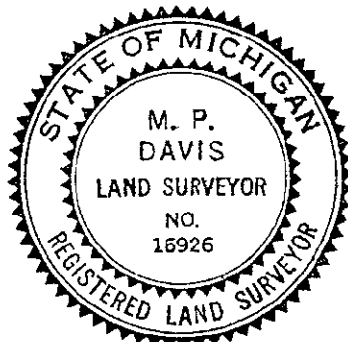

C. Description of monument for corner and accessories established to perpetuate locating the position of the corner:  
 A-13 SET, OVER EXISTING MONUMENT, A 5/8" X 18" REBAR W/A 3 1/4" ALUM CAP STAMPED TO ID THE COR POSITION & RAISED TO GRADE W/A MON BOX  
 MAPLE 6" 5/8" X 18" REBAR W/A SURVEY CAP 5/8" X 18" REBAR W/A SURVEY CAP SURVEY MONUMENT SIGN POST  
 N47°E 61.92 S45°E 50.00' S45°W 48.00' NORTH 26.00' (TO FACE)

NOTE: BEARINGS TO REFERENCE OBJECTS ARE MAGNETIC & DISTANCES ARE TO A NAIL IN THE CENTER OF THE OBJECT, UNLESS OTHERWISE NOTED.

Signed by M.P. Davis Date 12/10/96  
 Surveyor's Michigan License No. 16926