

**SURVEY & REMONUMENTATION**

MAR 21 1997

COMMISSION

**LAND CORNER RECORDATION CERTIFICATE**  
Filing Requirement of Act 74, Mich. P.A. 1970

Approved By Delta County  
Land Survey Remonumentation  
Peer Group Under Act 345 Of

P.A. Of 1990 On 12/12, 1996

*Robert C. Thomas*  
Chairman

For corners in

DELTA  
(County)

Located In:

Corner Code ≠

1. Public Land Survey	T	42	N	R	23	W	B-5	&	B-6
	T		R						
	T		R						
	T		R						
2. Property Controlling in Section	S		T		R				
	S		T		R				
3. Miscellaneous Property in Sec.	S		T		R				
	S		T		R				

Recorded DEC 20 1996  
at 2:00 o'clock PM  
Liber 8 Page 165  
*Robert C. Thomas*  
Delta County, Mich. Reg. of Deeds  
**Register of Deeds Stamp & File Number**

4. Lot No. \_\_\_\_\_, Recorded Plat \_\_\_\_\_  
5. Private Claims B-5 [N1/4 COR S.18] B-6 [C1/4 COR S.18]

A	B	C	D	E	F	G	H	I	J	K	L	M
2	6	5	4	3	2	1						
3												
4	7	8	9	10	11	12						
5												
6	13	17	16	15	14	13						
7												
8	19	20	21	22	23	24						
9												
10	30	29	28	27	26	25						
11												
12	31	32	33	34	35	36						
13												

I, M.P. DAVIS, in a field survey on 19 NOVEMBER, 19 96, do hereby certify that under requirements of P.A. 74, Michigan P.A. of 1970, the corner points mentioned in lines 1 and 2 above were in conformance with regulations and rules therefore as required in the current manual of survey instructions of the United States Department of the Interior, Bureau of Land Management or by a decree of a Court of Law and/or that the corner points mentioned in lines 3, 4 and 5 above were in conformance with the rules of the Michigan Board of Land Surveyors or by a Decree of a Court of Law; established, re-established, monumented, re-monumented, recovered, found as expressed below:

**NOTE: Not more than 4 corners, all in the same town and range, may be recorded on this certificate.**

A. Description of original monument and accessories and/or subsequent restoration:


B-5 [N1/4 COR S.18] E.C.MARTIN,D.S. -1852 - WOOD POST (DEAD CEDAR 12°-S35°E-54 LINKS) (DEAD CEDAR 12°-N15°W-15 LINKS)  
D.A.BROTHERTON-1910-ID CORNER POSITION BY "GLO" RANDOM LINES & NOTED NEW BT'S (TAMARACK 12°-N64°W-31.9')(TAMARACK 12°-S47°W-34.9  
J.E.GINGRASS-1912-IN PLACE AT INTERSECTION OF ROADS-NO NEW WIT'S NOTED

B-6 [C1/4 COR S.18] NOT SET IN ORIGINALS  
NO RECORD EVIDENCE OF CORNER MONUMENTATION

B. Description of corner evidence found and/or method applied in restoring or reestablishing corner:

B-5 [N1/4 COR S.18] NO CORNER EVIDENCE FOUND. RESTORED CORNER POSITION BY RETRACEMENT OF PORTIONS OF D.A.BROTHERTON'S 1910 SURVEY, J.E.GINGRASS'S 1912 SURVEY AND M.S.MCNABB'S 1913 ROAD ALIGNMENT SURVEY OF THE TROMBLY ROAD. UTILIZING MEASUREMENTS CONTAINED IN THE ABOVE MENTIONED SURVEYS N,S & E, W TO EXISTING CORNERS AND/OR LINES OF OCCUPATION TO ARRIVE AT A BEST FIT SOLUTION. OLD SURVEY RECORDS SHOW CORNER WAS FOUND AT INTERSECTION OF ROADS. OUR POSITION FITS THE C/L OF THE E-W COUNTY ROAD AND IS 4' M/L EAST OF THE C/L OF THE N-S COUNTY ROAD. ACCEPTED AS BEING THE BEST AVAILABLE EVIDENCE AS TO THE LOCATION OF THE POSITION OF THE ORIGINAL CORNER.

B-6 [C1/4 COR S.18] ESTABLISHED CORNER POSITION AT THE INTERSECTION OF THE N-S & E-W 1/4 LINES.

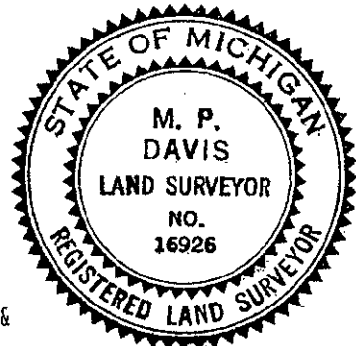

C. Description of monument for corner and accessories established to perpetuate locating the position of the corner:

B-5 SET, 6" BELOW ROAD SURFACE, A 5/8" X 18" REBAR W/A 3 1/4" ALUM CAP STAMPED TO ID THE CORNER POSITION.  
C.R. H-36 SIGN POST      SURVEY MONUMENT SIGN POST      STOP SIGN POST      DRILL HOLE IN FIELD STONE      NOTE: FARM FIELDS IN ALL 4 QUADRANTS  
N69°W                              N43°E                              S57°W                              S59°E  
68.09'                              37.51'                              45.72'                              62.93'

B-6 SET, 6" BELOW ROAD SURFACE, A 5/8" X 18" REBAR W/A 3 1/4" ALUM CAP STAMPED TO ID THE CORNER POSITION.  
ELM 6"      ELM 3"      MAPLE 5"      BALSAM 5"      SURVEY MONUMENT SIGN POST  
N59°W      N45°E      S78°E      S32°W      EAST  
46.28'      53.25'      36.10'      86.05'      17.93' (TO FACE)

NOTE: BEARINGS TO REFERENCE OBJECTS ARE MAGNETIC & DISTANCES ARE TO A NAIL IN THE CENTER OF THE OBJECT, UNLESS OTHERWISE NOTED.

Signed by M.P. Davis Date 12/10/96  
Surveyor's Michigan License No. 16926