[redacted]RVEY &
REMONUMENTATION

MAR 2 1 1997

COMMISSION

Approved By Delta County
Land Survey Remonumentation
Peer Group Under Act 345 Of
P.A. Of 1990 On 12/12, 1996
Chairman

LAND CORNER RECORDATION CERTIFICATE

Filing Requirement of Act 74, Mich. P.A. 1970

For corners in DELTA (County)

	Located In:	Corner Code ##
1. Public Land Survey	T 42 N R 23 W	B-9 & B-10
	T ___ R ___	
	T ___ R ___	
	T ___ R ___	
2. Property Controlling	S ___ T ___ R ___	
in Section	S ___ T ___ R ___	
3. Miscellaneous	S ___ T ___ R ___	
Property in Sec.	S ___ T ___ R ___	

Recorded DEC 20 1996
at 2:00 o'clock PM
Liber 8 Page 163
Delta County, MI Reg. of Deeds

Register of Deeds Stamp & File Number

4. Lot No. _____, Recorded Plat _____
5. Private Claims _____

B-9 [N1/4 COR S.30] B-10 [C1/4 COR S.30]

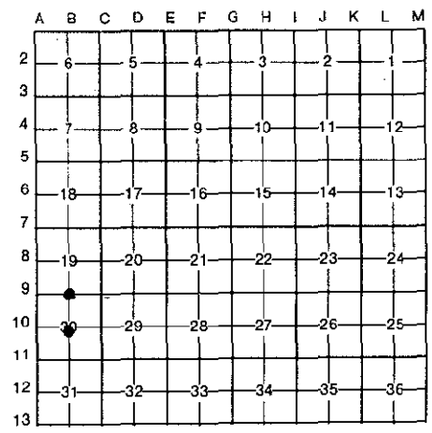

I, M.P. DAVIS, in a field survey on 22 OCTOBER, 19 96, do hereby certify that under requirements of P.A. 74, Michigan P.A. of 1970, the corner points mentioned in lines 1 and 2 above were in conformance with regulations and rules therefore as required in the current manual of survey instructions of the United States Department of the Interior, Bureau of Land Management or by a decree of a Court of Law and/or that the corner points mentioned in lines 3, 4 and 5 above were in conformance with the rules of the Michigan Board of Land Surveyors or by a Decree of a Court of Law; established, re-established, monumented, re-monumented, recovered, found as expressed below:

NOTE: Not more than 4 corners, all in the same town and range, may be recorded on this certificate.

A. Description of original monument and accessories and/or subsequent restoration:

B-9 [N1/4 COR S.30] E.C.MARTIN,D.S. -1852 - WOOD POST (CEDAR 16"-S44°E-26 LINKS) (FIR 08"-N58°W-15 LINKS)
NO RECORD EVIDENCE OF CORNER RECOVERY OR SUBSEQUENT REMONUMENTATION

B-10 [C1/4 COR S.30] NOT SET IN ORIGINALS
NO RECORD EVIDENCE OF CORNER MONUMENTATION

STATE OF MICHIGAN
M. P. DAVIS
LAND SURVEYOR
NO. 16926
REGISTERED LAND SURVEYOR

B. Description of corner evidence found and/or method applied in restoring or reestablishing corner:

B-9 [N1/4 COR S.30] NO EVIDENCE FOUND OF "GLO" BT'S OR OF SUBSEQUENT CORNER MONUMENTATION. RESET CORNER AT JCT. OF OLD FARM FENCES E-W AND N. ACCEPTED THIS POSITION AS THE BEST AVAILABLE EVIDENCE AS TO THE LOCATION OF THE POSITION OF THE ORIGINAL CORNER.

B-10 [C1/4 COR S.30] ESTABLISHED AT JCT OF E-W AND N-S 1/4 LINES.

C. Description of monument for corner and accessories established to perpetuate locating the position of the corner:

B-9 SET BERNTSEN A1NB30 ALUM MONUMENT WITH THE CAP STAMPED TO ID THE CORNER POSITION.

MAPLE 05"	MAPLE 06"	SURVEY MONUMENT SIGN POST	NOTE: CLEAR CUT IN THE NE & NW QUADRANTS
S49°E	S33°W	NORTH	
23.50'	14.88'	2.79' (TO FACE)	

B-10 SET 5/8" X 18" REBAR W/A 3 1/4" ALUM CAP STAMPED TO ID THE CORNER POSITION.
NOTE: NO WIT'S AVAILABLE - CORNER POSITION FALLS IN CULIVATED FARM FIELDS IN ALL FOUR QUADRANTS.
CORNER FENCE POST IS 25' WEST AND 11' SOUTH OF CORNER MONUMENT.

NOTE: BEARINGS TO REFERENCE OBJECTS ARE MAGNETIC & DISTANCES ARE TO A NAIL IN THE CENTER OF THE OBJECT, UNLESS OTHERWISE NOTED.

Signed by M.P. Davis Date 12/10/96

Surveyor's Michigan License No. 16926

FORM APPROVED BY MICHIGAN STATE BOARD OF LAND SURVEYORS, JAN. 28, 1971
REVISED MAY 14, 1975
REVISED JAN., 1983