

MAR 21 1997

COMMISSION

Approved By Delta County  
Land Survey Remonumentation  
Peer Group Under Act 345 Of

P.A. Of 1990 On 12/12, 1996

**LAND CORNER RECORDATION CERTIFICATE**  
Filing Requirement of Act 74, Mich. P.A. 1970

*Walter C. Thomas*  
Acting Chairman

For corners in  
DELTA  
(County)

Located In: Corner Code #

- |                                    |                         |       |
|------------------------------------|-------------------------|-------|
| 1. Public Land Survey              | T 42 N R 23 W           | B-13  |
|                                    | T _____ R _____         | _____ |
|                                    | T _____ R _____         | _____ |
|                                    | T _____ R _____         | _____ |
| 2. Property Controlling in Section | S _____ T _____ R _____ | _____ |
|                                    | S _____ T _____ R _____ | _____ |
| 3. Miscellaneous Property in Sec.  | S _____ T _____ R _____ | _____ |
|                                    | S _____ T _____ R _____ | _____ |

Recorded DEC 20 1996  
at 2:00 o'clock P.M.  
Liber 8 Page 188  
*Walter C. Thomas*  
Delta County, MI Reg. of Deeds

Register of Deeds Stamp & File Number


4. Lot No. \_\_\_\_\_, Recorded Plat \_\_\_\_\_  
5. Private Claims B-13 [S1/4 COR S.31]

	A	B	C	D	E	F	G	H	I	J	K	L	M
2	6		5		4		3		2		1		
3													
4	7		8		9		10		11		12		
5													
6	18		17		16		15		14		13		
7													
8	19		20		21		22		23		24		
9													
10	30		29		28		27		26		25		
11													
12	31		32		33		34		35		36		
13													

I, M.P. DAVIS, in a field survey on 10 DECEMBER, 1996, do hereby certify that under requirements of P.A. 74, Michigan P.A. of 1970, the corner points mentioned in lines 1 and 2 above were in conformance with regulations and rules therefore as required in the current manual of survey instructions of the United States Department of the Interior, Bureau of Land Management or by a decree of a Court of Law and/or that the corner points mentioned in lines 3, 4 and 5 above were in conformance with the rules of the Michigan Board of Land Surveyors or by a Decree of a Court of Law; established, re-established, monumented, re-monumented, recovered, found as expressed below:

**NOTE: Not more than 4 corners, all in the same town and range, may be recorded on this certificate.**

- A. Description of original monument and accessories and/or subsequent restoration:  
B-13 [S1/4 COR S.31] JOHN BURT, D.S. - 1845 - WOOD POST (Y. BIRCH 08°-N56°E-16 LINKS) (FIR 12°-N24°W-24 LINKS)  
D.A. BROTHERTON-1912-SET IRON & STAKE PROPORTIONATE DISTANCE BETWEEN CORNERS (HUBS N & S 33')  
M.S. McNABB-1945- IRON IN PLACE - COR FENCE POST - S8°E-14.5' ELM 8"-S80°W-81.2'  
M.DAVIS, RLS-1976-L.5 OF LCR'S PG.3-RESTORED COR POSITION FROM McNABB'S FENCE POST BT-C/L OF C.R.430 NORTH 18.7' (NO OTHER WIT'S NEAR

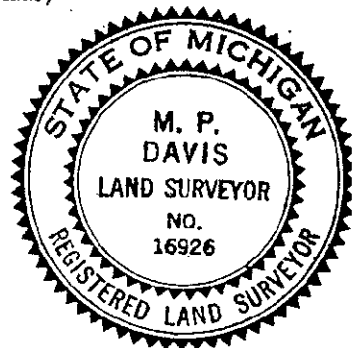

- B. Description of corner evidence found and/or method applied in restoring or reestablishing corner:  
B-13 [S1/4 COR S.31] CORNER MONUMENT AS ESTABLISHED BY MYSELF IN 1976 HAS BEEN DESTROYED DURING RECONSTRUCTION OF COUNTY ROAD 430. RESTORED CORNER POSITION BY RETRACEMENT OF PORTIONS OF MY 1976 SURVEY.

- C. Description of monument for corner and accessories established to perpetuate locating the position of the corner:  
B-13 SET, 6" BELOW GRADE & ON SOUTH SHOULDER OF COUNTY ROAD 430 A 5/8" X 20" IRON PIN W/A 3/4" ALUM CAP STAMPED TO ID THE CORNER POSITION.  
DRILL HOLE IN LARGE FIELD STONE      SURVEY MONUMENT SIGN POST      C/L COUNTY ROAD 430  
S47°W      NORTH      NORTH  
39.62'      37.43' (TO FACE)      17'

NOTE: OPEN FIELDS IN ALL FOUR QUADRANTS - NO OTHER WIT'S NEAR.

NOTE: BEARINGS TO REFERENCE OBJECTS ARE MAGNETIC & DISTANCES ARE TO A NAIL IN THE CENTER OF THE OBJECT, UNLESS OTHERWISE NOTED.

Signed by M.P. Davis Date 12/10/96  
Surveyor's Michigan License No. 10926