

SURVEY & REMONUMENTATION

MAR 21 1997

COMMISSION

LAND CORNER RECORDATION CERTIFICATE
Filing Requirement of Act 74, Mich. P.A. 1970

Approved by Delta County
Land Survey Remonumentation
Peer Group Under Act 345 Of
P.A. Of 1990 On 12/12, 1996
Robert C. Thorne
Acting Chairman

For corners in
DELTA
(County)

Located In: Corner Code #/

- | | | |
|------------------------------------|-----------------------------|----------------------|
| 1. Public Land Survey | T <u>42</u> N R <u>23</u> W | <u>C-5 & C-6</u> |
| | T _____ R _____ | _____ |
| | T _____ R _____ | _____ |
| | T _____ R _____ | _____ |
| 2. Property Controlling in Section | S _____ T _____ R _____ | _____ |
| | S _____ T _____ R _____ | _____ |
| 3. Miscellaneous Property in Sec. | S _____ T _____ R _____ | _____ |
| | S _____ T _____ R _____ | _____ |

Recorded DEC 20 1996
at 2:00 o'clock PM
Liber 8 Page 160
Walter C. Thorne
Delta County, MI Reg. of Deeds

Register of Deeds Stamp & File Number

4. Lot No. _____, Recorded Plat _____
5. Private Claims C-5 [NW COR S.17] C-6 [W1/4 COR S.17]

	A	B	C	D	E	F	G	H	I	J	K	L	M
2	6		5		4		3		2		1		
3													
4	7		8		9		10		11		12		
5													
6	18		17		16		15		14		13		
7													
8	19		20		21		22		23		24		
9													
10	30		29		28		27		26		25		
11													
12	31		32		33		34		35		36		
13													

I, M.P. DAVIS, in a field survey on 19 NOVEMBER, 19 96, do hereby certify that under requirements of P.A. 74, Michigan P.A. of 1970, the corner points mentioned in lines 1 and 2 above were in conformance with regulations and rules therefore as required in the current manual of survey instructions of the United States Department of the Interior, Bureau of Land Management or by a decree of a Court of Law and/or that the corner points mentioned in lines 3, 4 and 5 above were in conformance with the rules of the Michigan Board of Land Surveyors or by a Decree of a Court of Law; established, re-established, monumented, re-monumented, recovered, found as expressed below:


NOTE: Not more than 4 corners, all in the same town and range, may be recorded on this certificate.

A. Description of original monument and accessories and/or subsequent restoration:
C-5 [NW COR S.17] E.C.MARTIN, D.S. - 1852 - WOOD POST (DEAD CEDAR 08"-S28°E-32 LINKS) (W.BIRCH 30"-N39°W-57 LINKS)
M.S.McNABB-1913-ID CORNER POSITION FROM ORIGINALS-NO NEW WIT'S NOTED

C-6 [W1/4 COR S.17] E.C.MARTIN, D.S. - 1852 - WOOD POST (MAPLE 10"-S52°W-08 LINKS) (CEDAR 06"-N41°E-04 LINKS)
NO RECORD EVIDENCE OF CORNER RECOVERY OR SUBSEQUENT REMONUMENTATION

B. Description of corner evidence found and/or method applied in restoring or reestablishing corner:
C-5 [NW COR S.17] NO EVIDENCE OF McNABB'S 1913 CORNER AS ID FROM THE "ORIGINALS" FOUND. REESTABLISHED CORNER POSITION A JCT. OF ANCIENT FENCE LINE SOUTH & C/L OF THE TROMBLY ROAD EAST & WEST. THIS CORNER POSITION MATCHES WELL WITH McNABB'S ROAD ALIGNMENT SURVEY OF THE TROMBLY ROAD. ACCEPTED THIS POSITION AS BEING THE BEST AVAILABLE EVIDENCE AS TO THE LOCATION OF THE POSITION OF THE ORIGINAL CORNER.

C-6 [W1/4 COR S.17] NO CORNER EVIDENCE FOUND. ESTABLISHED CORNER AT MIDPOINT BETWEEN SEC COR'S 1/2 N & S. CORNER POSITION IS LOCATED IN AN ISOLATED WOODED AREA WITH NO INDICATION OF OCCUPATION OR CORNER WORK. COR IS 30' M/L SE OF CHAMPION INTERNATIONAL LOCATOR TAG & CRUISER POST.

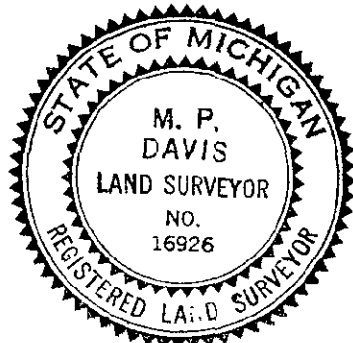

C. Description of monument for corner and accessories established to perpetuate locating the position of the corner:

C-5 SET, 6" BELOW ROAD SURFACE, A 5/8" X 18" REBAR W/A 3 1/4" ALUM CAP STAMPED TO ID THE CORNER POSITION.
POWER POLE SPRUCE 26" SURVEY MONUMENT SIGN POST NOTE: TAG ALDER SWAMP IN THE NW & NE QUADRANTS
S76°W S50°E SOUTH
85.51' (TO FACE) 86.12' 16.39' (TO FACE)

C-6 SET BERNTSEN AINB30 ALUM MONUMENT WITH THE CAP STAMPED TO ID THE CORNER POSITION.
CEDAR 07" MAPLE 10" MAPLE 07" CEDAR 06" SURVEY MONUMENT SIGN POST
N43°W N34°E S65°E S39°W SOUTH
24.26' 4.14' 14.31' 42.08' 2.39' (TO FACE)

NOTE: BEARINGS TO REFERENCE OBJECTS ARE MAGNETIC & DISTANCES ARE TO A NAIL IN THE CENTER OF THE OBJECT, UNLESS OTHERWISE NOTED.

Signed by M.P. Davis Date 12/10/96
Surveyor's Michigan License No. 16926