

**SURVEY &
REMONUMENTATION**

MAR 21 1997

COMMISSION

LAND CORNER RECORDATION CERTIFICATE
Filing Requirement of Act 74, Mich. P.A. 1970

Approved By Delta County
Land Survey Remonumentation
Peer Group Under Act 345 Of

P.A. Of 1990 On 12/12, 1996

Walter C. Thomas
Chairman

For corners in
DELTA
(County)

Located In: Corner Code #

- | | | |
|------------------------------------|-----------------------------|----------------|
| 1. Public Land Survey | T <u>42</u> N R <u>23</u> W | C-7 <u>C-8</u> |
| | T ___ R ___ | _____ |
| | T ___ R ___ | _____ |
| | T ___ R ___ | _____ |
| 2. Property Controlling in Section | S ___ T ___ R ___ | _____ |
| | S ___ T ___ R ___ | _____ |
| 3. Miscellaneous Property in Sec. | S ___ T ___ R ___ | _____ |
| | S ___ T ___ R ___ | _____ |

Recorded DEC 20 1996
at 2:00 o'clock PM
Liber 8 Page 159
Walter C. Thomas
Delta County, MI Dept. of Deeds

Register of Deeds Stamp & File Number

4. Lot No. _____, Recorded Plat _____
5. Private Claims C-7 [NW COR S.20] C-8 [W1/4 COR S.20]

I, M.P. DAVIS, in a field survey on 14 NOVEMBER, 19 96, do hereby certify that under requirements of P.A. 74, Michigan P.A. of 1970, the corner points mentioned in lines 1 and 2 above were in conformance with regulations and rules therefore as required in the current manual of survey instructions of the United States Department of the Interior, Bureau of Land Management or by a decree of a Court of Law and/or that the corner points mentioned in lines 3, 4 and 5 above were in conformance with the rules of the Michigan Board of Land Surveyors or by a Decree of a Court of Law; established, re-established, monumented, re-monumented, recovered, found as expressed below:

	A	B	C	D	E	F	G	H	I	J	K	L	M
2	6		5		4		3		2		1		
3													
4	7		8		9		10		11		12		
5													
6	18		17		16		15		14		13		
7													
8	19		20		21		22		23		24		
9													
10	30		29		28		27		26		25		
11													
12	31		32		33		34		35		36		
13													

NOTE: Not more than 4 corners, all in the same town and range, may be recorded on this certificate.

A. Description of original monument and accessories and/or subsequent restoration:


C-7 [NW COR S.20] E.C.MARTIN, D.S. - 1852 - WOOD POST (Y.BIRCH 16°-S44°E-21 LINKS) (Y.BIRCH 16°-N65°W-14 LINKS)
NO RECORD EVIDENCE OF CORNER RECOVERY OR SUBSEQUENT CORNER MONUMENTATION

C-8 [W1/4 COR S.20] E.C.MARTIN, D.S. - 1852 - WOOD POST (HEMLOCK 10°-S30°E-02 LINKS) (CEDAR 12°-N38°W-30 LINKS)
NO RECORD EVIDENCE OF CORNER RECOVERY OR SUBSEQUENT REMONUMENTATION

B. Description of corner evidence found and/or method applied in restoring or reestablishing corner:

C-7 [NW COR S.20] NO CORNER EVIDENCE FOUND. THIS CORNER WAS ESTABLISHED IN THE ORIGINAL SURVEY ON A STRAIGHT LINE BETWEEN CORRESPONDING CORNERS ON THE EAST & WEST LINES OF THE TOWNSHIP. IN AS MUCH AS ORIGINAL EVIDENCE WAS FOUND AT THE NW CORNERS OF SEC'S 19 & 22 IT WAS THEREFORE DECIDED TO STAY WITH THE SPIRIT OF THE ORIGINAL SURVEYS AND TO ESTABLISH THIS CORNER ON LINE WITH THE NW COR'S OF SEC'S 19 & 22 AND SINGLE PROPORTIONATE DISTANCE BETWEEN THE W1/4 COR OF SEC 19 & THE NW COR OF SEC 22.

C-8 [W1/4 COR S.20] NO CORNER EVIDENCE FOUND, AREA HAS BEEN CLEAR CUT. ESTABLISHED CORNER POSITION AT MIDPOINT BETWEEN SECTION CORNERS 1/2 MILE NORTH & SOUTH.

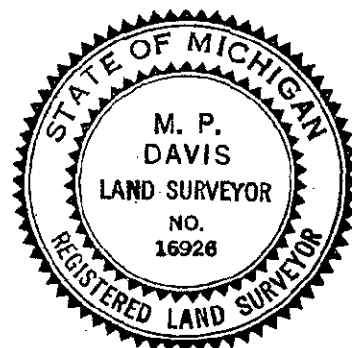

C. Description of monument for corner and accessories established to perpetuate locating the position of the corner:

C-7 SET A BERNTSEN A1NB30 ALUM MONUMENT WITH THE CAP STAMPED TO ID THE CORNER POSITION.

CEDAR 08"	CEDAR 08"	SURVEY MONUMENT SIGN POST	NOTE: CLEAR CUT IN THE SE & SW QUADRANTS
N23°W	N42°E	EAST	NO WIT'S AVAILABLE
44.78'	30.39'	2.31' (TO FACE)	

C-8 SET A BERNTSEN A1NB30 ALUM MONUMENT WITH THE CAP STAMPED TO ID THE CORNER POSITION.

MAPLE, TWIN 9"	MAPLE 10"	MAPLE, TWIN 7"	SURVEY MONUMENT SIGN POST	NOTE: 44' M/L LESS SOUTH OF WOODS ROAD
N03°E	N56°E	S50°W	SOUTH	NW-SE
25.81'	59.16'	26.92'	2.21' (TO FACE)	

NOTE: BEARINGS TO REFERENCE OBJECT ARE MAGNETIC & DISTANCES ARE TO A NAIL IN THE CENTER OF THE OBJECT, UNLESS NOTED OTHERWISE.

Signed by M.P. Davis Date 12/10/96

Surveyor's Michigan License No. 16926