

REMONUMENTATION

MAR 21 1997

COMMISSION

LAND CORNER RECORDATION CERTIFICATE
 Filing Requirement of Act 74, Mich. P.A. 1970

Approved By Delta County
 Land Survey Remonumentation
 Peer Group Under Act 345 Of
 P.A. Of 1990 On 12/12, 1996
Robert Schmalwig
 Chairman

For corners in

DELTA

(County)

Located In:

Corner Code ##

- | | | | | | | | |
|------------------------------------|---|----|---|---|----|---|-------------------------|
| 1. Public Land Survey | T | 42 | N | R | 23 | W | <u>D-5</u> & <u>D-7</u> |
| | T | | R | | | | |
| | T | | R | | | | |
| | T | | R | | | | |
| 2. Property Controlling in Section | S | | T | | R | | |
| | S | | T | | R | | |
| 3. Miscellaneous Property in Sec. | S | | T | | R | | |
| | S | | T | | R | | |

Recorded DEC 20 1996
 at 2:00 o'clock PM
 Liber 8 Page 156
William C. Thomas
 Delta County, MI Reg. of Deeds

Register of Deeds Stamp & File Number

4. Lot No. _____, Recorded Plat _____
 5. Private Claims D-5 [N1/4 COR S17] D-7 [N1/4 COR S.20]

A	B	C	D	E	F	G	H	I	J	K	L	M
2	6	5	4	3	2	1						
3												
4	7	8	9	10	11	12						
5												
6	18	17	16	15	14	13						
7												
8	19	20	21	22	23	24						
9												
10	30	29	28	27	26	25						
11												
12	31	32	33	34	35	36						
13												

I, M.P. DAVIS, in a field survey on 19 NOVEMBER, 19 96, do hereby certify that under requirements of P.A. 74, Michigan P.A. of 1970, the corner points mentioned in lines 1 and 2 above were in conformance with regulations and rules therefore as required in the current manual of survey instructions of the United States Department of the Interior, Bureau of Land Management or by a decree of a Court of Law and/or that the corner points mentioned in lines 3, 4 and 5 above were in conformance with the rules of the Michigan Board of Land Surveyors or by a Decree of a Court of Law; established, re-established, monumented, re-monumented, recovered, found as expressed below:

NOTE: Not more than 4 corners, all in the same town and range, may be recorded on this certificate.

A. Description of original monument and accessories and/or subsequent restoration:

D-5 [N1/4 COR S.17] E.C.MARTIN, D.S. - 1852 - WOOD POST (SUGAR 18°-S38°E-40 LINKS) (Y.BIRCH 20°-N32°W-89 LINKS) M.S.McNABB-1913-ROAD ALIGNMENT SURVEY OF THE TROMBLY RD.- ID FROM ORIGINALS (HEMLOCK 5°-N6°E-40.0')

D-7 [N1/4 COR S.20] E.C.MARTIN, D.S. - 1852 - ELM 10" CORNER TREE (CEDAR 18°-N22°W-29 LINKS) NO RECORD EVIDENCE OF CORNER RECOVERY OR SUBSEQUENT MONUMENTATION.

B. Description of corner evidence found and/or method applied in restoring or reestablishing corner:

D-5 [N1/4 COR S.17] NO EVIDENCE OF McNABB'S 1913 CORNER OR HEMLOCK BT FOUND. RESTORED CORNER POSITION ON LINE WITH SEC COR'S 1/2 MILE E & W AND PROPORTIONATE DISTANCE EAST OF AN ANCIENT FENCE LINE TO THE NORTH AT THE W1/16 LINE COR. THE DISTANCE FOR THE WEST HALF MILE OF THE SEC FITS REASONABLY WELL WITH McNABB'S RECORDS. THE EAST HALF MILE APPEARS TO BE WHERE A BLUNDER OCCURED IN McNABB'S DISTANCES AS OUR DISTANCE FOR THE LENGTH OF THE TROMBLY RD IS 60' M/L LONGER THAN CONTAINED IN McNABB'S RECORDS.


D-7 [N1/4 COR S.20] NO CORNER EVIDENCE FOUND. REESTABLISHED CORNER POSITION AT MIDPOINT BETWEEN SECTION CORNERS 1/2 MILE E & W. CORNER POSITION FALLS IN THE NEAR VICINITY OF CHAMPION LUMBER CO'S CRUISER POST AND LOCATOR TAG.

C. Description of monument for corner and accessories established to perpetuate locating the position of the corner:

D-5 SET 5/8" X 18" REBAR W/A 3 1/4" ALUM CAP STAMPED TO ID THE CORNER POSITION & RAISED TO GRADE W/A MONUMENT BOX.
 BALSAM SPRUCE 09" SPRUCE 10" SURVEY MONUMENT SIGN POST
 N19°W S28°E S25°W N3°E
 41.36' 43.50' 52.76' 16.58' (TO FACE)

D-7 SET A BERNTSEN A1NB30 ALUM MONUMENT WITH THE CAP TO STAMPED TO ID THE CORNER POSITION.
 CEDAR 08" CEDAR 09" CEDAR 05" CEDAR 09" SURVEY MONUMENT SIGN POST
 N72°W N32°E S23°E S47°W SOUTH
 21.35' 24.68' 12.81' 10.06' 2.41' (TO FACE)

NOTE: BEARINGS TO REFERENCE OBJECTS ARE MAGNETIC & DISTANCES ARE TO A NAIL IN THE CENTER OF THE OBJECT, UNLESS OTHERWISE NOTED.

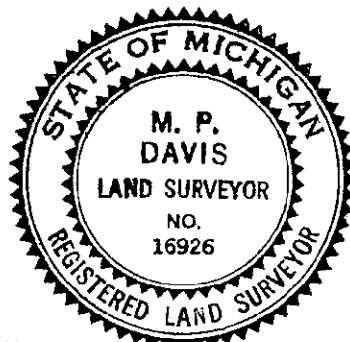

Signed by M.P. Davis Date 12/10/96
 Surveyor's Michigan License No. 16926