

**SURVEY &
REMONUMENTATION**

MAR 2 1 1997

COMMISSION

Approved By Delta County
Land Survey Remonumentation
Peer Group Under Act 345 Of

P.A. Of 1990 On 12/12, 1996

LAND CORNER RECORDATION CERTIFICATE
Filing Requirement of Act 74, Mich. P.A. 1970

John Schmeling
Acting Chairman

For corners in

DELTA

County:

Located In:

Corner Code #/

- | | | |
|------------------------------------|-----------------------------|-------------------------|
| 1. Public Land Survey | T <u>42</u> N R <u>23</u> W | <u>E-5</u> & <u>E-7</u> |
| | T _____ R _____ | _____ |
| | T _____ R _____ | _____ |
| | T _____ R _____ | _____ |
| 2. Property Controlling in Section | S _____ T _____ R _____ | _____ |
| | S _____ T _____ R _____ | _____ |
| 3. Miscellaneous Property in Sec. | S _____ T _____ R _____ | _____ |
| | S _____ T _____ R _____ | _____ |

Recorded DEC 20 1996
 @ 2:00 o'clock PM
 Liber 8 Page 171
Walter C. Thomas
 Delta County, Mich. Reg. of Deeds

Register of Deeds Stamp & File Number

4. Lot No. _____, Recorded Plat _____
 5. Private Claims E-5 [NW COR S16] E-7 [NW COR S21]

	A	B	C	D	E	F	G	H	I	J	K	L	M
2	6	5	4	3	2								
3													
4	7	8	9	10	11	12							
5													
6	18	17	16	15	14	13							
7													
8	19	20	21	22	23	24							
9													
10	30	29	28	27	26	25							
11													
12	31	32	33	34	35	36							

I, M.P. DAVIS, in a field survey on 19 NOVEMBER, 19 96, do hereby certify that under requirements of P.A. 74, Michigan P.A. of 1970, the corner points mentioned in lines 1 and 2 above were in conformance with regulations and rules therefore as required in the current manual of survey instructions of the United States Department of the Interior, Bureau of Land Management or by a decree of a Court of Law and/or that the corner points mentioned in lines 3, 4 and 5 above were in conformance with the rules of the Michigan Board of Land Surveyors or by a Decree of a Court of Law; established, re-established, monumented, re-monumented, recovered, found as expressed below:

NOTE: Not more than 4 corners, all in the same town and range, may be recorded on this certificate.

A. Description of original monument and accessories and/or subsequent restoration:

E-5 [NW COR S.16] E.C.MARTIN, D.S. - 1852 - WOOD POST (CEDAR 18"-S26°W-21 LINKS) (CEDAR 14"-N45°E-38 LINKS) M.S.MCNABB-1913-RD ALIGNMENT SURVEY OF THE TROMBLY ROAD, ID FROM ORIGINALS, NO NEW BT'S NOTED.

E-7 [NW COR S.21] E.C.MARTIN, D.S. - 1852 - WOOD POST (CEDAR 10"-S15°E-18 LINKS)(CEDAR 14'-N22°W-19 LINKS) NO RECORD EVIDENCE OF CORNER RECOVERY OR SUBSEQUENT MONUMENTATION.

B. Description of corner evidence found and/or method applied in restoring or reestablishing corner:

E-5 [NW COR S.16] NO EVIDENCE OF McNABB'S 1913 CORNER FOUND. REESTABLISHED CORNER POSITION FROM INFORMATION CONTAINED IN McNABB'S FIELD NOTES FOR THE SURVEY OF THE TROMBLY ROAD. USED THE EXISTING C/L OF THE TROMBLY ROAD FOR N-S CONTROL & McNABB'S RECORDED DISTANCE WEST OF THE NE COR OF SEC 16 AS THIS GIVES THE BEST FIT POSITION & MATCHES WELL WITH "GLO" POSITION TO ADJOINING CORNERS.


E-7 [NW COR S.20] NO CORNER EVIDENCE FOUND. THIS CORNER WAS ESTABLISHED IN THE ORIGINAL SURVEY ON A STRAIGHT LINE BETWEEN CORRESPONDING CORNERS ON THE EAST & WEST LINES OF THE TOWNSHIP. IN AS MUCH AS ORIGINAL EVIDENCE WAS FOUND AT THE NW CORNERS OF SEC'S 19 & 22 IT WAS THEREFORE DECIDED TO STAY WITH THE SPIRIT OF THE ORIGINAL SURVEYS AND TO ESTABLISH THIS CORNER ON LINE WITH THE NW COR'S OF SEC'S 19 & 22 AND SINGLE PROPORTIONATE DISTANCE BETWEEN THE N1/4 COR OF SEC 19 & THE NW COR OF SEC 22.

C. Description of monument for corner and accessories established to perpetuate locating the position of the corner:

E-5 SET, 6" BELOW GRADE, A 5/8" X 18" REBAR W/A 3 1/4" ALUM CAP STAMPED TO ID THE CORNER POSITION.
 W.BIRCH 10" W.BIRCH 07" 1 1/4" IRON PIPE SURVEY MONUMENT SIGN POST
 N29°E S38°E S38°W SOUTH
 27.85' 67.93' 27.05' 15.90' (TO FACE)

E-3 SET A BERNTSEN ALNB30 ALUM MON WITH THE CAP STAMPED TO ID THE COR POSITION.
 CEDAR 07" SURVEY MONUMENT SIGN POST NOTE: CORNER POSITION FALLS ON SOUTH EDGE OF E-W WOODS ROAD NOW BEING USED FOR A DAM SITE BY BEAVERS, FLOODING IN THE NE & NW QUADRANTS AND RECENT CLEAR CUTS IN THE SE & SW QUADRANTS. NO OTHER WIT'S AVAILABLE.
 N35°W EAST
 42.64' 1.40' (TO FACE)

NOTE: BEARINGS TO REFERENCE OBJECTS ARE MAGNETIC & DISTANCES ARE TO A NAIL IN THE CENTER OF THE OBJECT, UNLESS OTHERWISE NOTED.

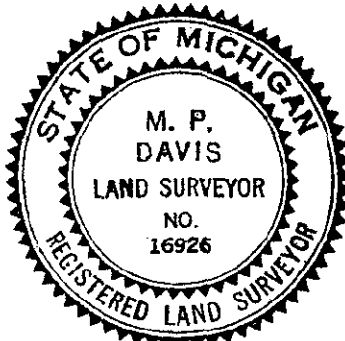

Signed by M.P. Davis Date 12/10/96
 Surveyor's Michigan License No. 16926