

SURVEY & REMONUMENTATION

MAR 21 1997

COMMISSION

Approved By Delta County
Land Survey Remonumentation
Peer Group Under Act 345 Of
P.A. Of 1990 On 12/12, 1996
Robert Helmberg
Chairman

LAND CORNER RECORDATION CERTIFICATE
Filing Requirement of Act 74, Mich. P.A. 1970

For corners in
DELTA
(County)

Located In: Corner Code #

- | | | |
|------------------------------------|-----------------------------|--------------------------|
| 1. Public Land Survey | T <u>42 N</u> R <u>23 W</u> | <u>L-9</u> & <u>L-13</u> |
| | T _____ R _____ | _____ |
| | T _____ R _____ | _____ |
| | T _____ R _____ | _____ |
| 2. Property Controlling in Section | S _____ T _____ R _____ | _____ |
| | S _____ T _____ R _____ | _____ |
| 3. Miscellaneous Property in Sec. | S _____ T _____ R _____ | _____ |
| | S _____ T _____ R _____ | _____ |

Recorded DEC 20 1996
at 2:00 o'clock P.M.
Liber 8 Page 181
William C. Thomas
Delta County, MI Reg. of Deeds

Register of Deeds Stamp & File Number

4. Lot No. _____, Recorded Plat _____
5. Private Claims L-9 [N1/4 COR S25] L-13 [S1/4 COR S.36]

	A	B	C	D	E	F	G	H	I	J	K	L	M
2	6	5	4	3	2								
3													
4	7	8	9	10	11	12							
5													
6	18	17	16	15	14	13							
7													
8	19	20	21	22	23	24							
9													
10	30	29	28	27	26	25							
11													
12	31	32	33	34	35	36							
13													

I, M.P. DAVIS, in a field survey on NOVEMBER, 1996, do hereby certify that under requirements of P.A. 74, Michigan P.A. of 1970, the corner points mentioned in lines 1 and 2 above were in conformance with regulations and rules therefore as required in the current manual of survey instructions of the United States Department of the Interior, Bureau of Land Management or by a decree of a Court of Law and/or that the corner points mentioned in lines 3, 4 and 5 above were in conformance with the rules of the Michigan Board of Land Surveyors or by a Decree of a Court of Law; established, re-established, monumented, re-monumented, recovered, found as expressed below:


NOTE: Not more than 4 corners, all in the same town and range, may be recorded on this certificate.

A. Description of original monument and accessories and/or subsequent restoration:
L-9 [N1/4 COR S.25] E.C.MARTIN, D.S. - 1852 - WOOD POST (HEMLOCK 12"-N22°E-13 LINKS)(CEDAR 6"-S40°W-12 LINKS)
D.A.BROTHERTON-DATE UNKNOWN-CEDAR STAKE IN PLACE-NO WIT'S NOTED
M.D.O.T-1937 ALIGNMENT SURVEY FOR HWY. M-35-COR IN PLACE, FOUND IRON PIN, NO WIT'S NOTED

L-13 [S1/4 COR S.36] JOHN BURT, D.S. - 1845 - WOOD POST - (SPRUCE 10"-N23°W-16 LINKS)(FIR 03"-N37°W-06 LINKS)
M.S.McNABB-1913-STAKE IN PLACE, 81.6' NORTH OF RR TRACK (CEDAR 6"-S11°W-33.4")(Y.BIRCH 09"-N10°E-41.9')
FRANK BRAY-1969-SET 1 1/4" I.P. FROM RECORDS OF McNABB, 81.6" NORTH OF RR TRACK & REC'D IN LIBER 4 OF LCR'S PAGE 155 (PP-N11°E 48.8')(FENCE CORNER S1°W-34.9')

B. Description of corner evidence found and/or method applied in restoring or reestablishing corner:
L-9 [N1/4 COR S.25] FOUND IN PLACE A 1" IRON PIN. ID FROM TIES TO HWY. M-35 C/L AS PER M.D.O.T 1937 SURVEY. ACCEPTED EXISTING MONUMENT AS THE BEST AVAILABLE EVIDENCE AS TO THE LOCATION OF THE POSITION OF THE ORIGINAL CORNER.

L-13 [S1/4 COR S.36] FOUND IN PLACE A 1/2" REBAR AS DESCRIBED IN LIBER 4 OF LCR'S PAGE 156. ID CORNER POSITION FROM BRAY'S FENCE POST BY & OLD RR BED SOUTH 81.6'. ACCEPTED EXISTING MONUMENT AS BEING THE BEST AVAILABLE EVIDENCE AS TO THE LOCATION OF THE POSITION OF THE ORIGINAL CORNER.

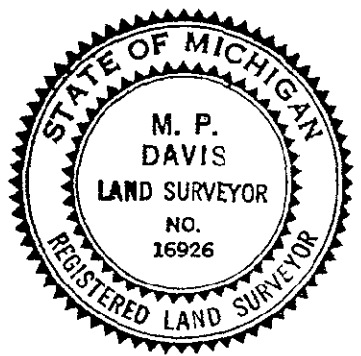

C. Description of monument for corner and accessories established to perpetuate locating the position of the corner:
L-9 SET, OVER EXISTING MONUMENT, A BERNTSEN AINB30 ALUM MONUMENT WITH THE CAP STAMPED TO ID THE COR POSITION.
TAMARACK 3" SPRUCE SURVEY MONUMENT SIGN POST NOTE: CORNER IS LOCATED IN THE MEDIAN BETWEEN THE C.NW. RR TO THE EAST & COUNTY RD. H-52 TO THE WEST. NO OTHER WIT'S AVAILABLE.
N11°W S45°W S55°E
25.57' 8.10' 1.91' (TO FACE)

L-13 SET, OVER EXISTING MONUMENT, A 5/8" X 18" REBAR W/A 3 1/4" ALUM CAP STAMPED TO ID THE COR POSITION RAISED TO GRADE W/A MON BOX.
CEDAR 06" CEDAR 08" 5/8" X 18" REBARS W/A SURVEY CAP SURVEY MONUMENT SIGN POST
S21°E S50°W N45°W N45°E NORTH
59.02' 77.58' 23.00' 23.00' 22.04' (TO FACE)

NOTE: BEARINGS TO REFERENCE OBJECTS ARE MAGNETIC & DISTANCES ARE TO A NAIL IN THE CENTER OF THE OBJECT, UNLESS OTHERWISE NOTED.

Signed by M.P. Davis Date 12/10/96
Surveyor's Michigan License No. 16926