

SURVEY & REMONUMENTATION

JAN 14 1998

LAND CORNER RECORDATION CERTIFICATE
Filing Requirement of Act 74, Mich. P.A. 1970

Approved By Delta County
Land Survey Remonumentation
Peer Group Under Act 345 Of
P.A. Of 1990 On 12/18, 1992
Walter C. Thoren
Acting Chairman

For corners in **SECTION**
DELTA
(County)

Located In: Corner Code #

- | | | |
|------------------------------------|-----------------------------|------------------------|
| 1. Public Land Survey | T <u>42</u> N R <u>22</u> W | <u>A-05 & A-06</u> |
| | T <u>42</u> N R <u>23</u> W | <u>M-05 & M-06</u> |
| | T _____ R _____ | _____ |
| | T _____ R _____ | _____ |
| 2. Property Controlling in Section | S _____ T _____ R _____ | _____ |
| | S _____ T _____ R _____ | _____ |
| 3. Miscellaneous Property in Sec. | S _____ T _____ R _____ | _____ |
| | S _____ T _____ R _____ | _____ |

Dec 19 1997
9:00 AM
8 286
Walter C. Thoren

Register of Deeds Stamp & File Number

4. Lot No. _____, Recorded Plat _____
5. Private Claims _____
A-05 [NW SEC 18] A-06 [W1/4 SEC 18] SAME CORNERS AS M-05, M-06

A	B	C	D	E	F	G	H	I	J	K	L	M
2	6	5	4	3	2	1						
3												
4	7	8	9	10	11	12						
5												
6	18	17	16	15	14	13						
7												
8	19	20	21	22	23	24						
9												
10	30	29	28	27	26	25						
11												
12	31	32	33	34	35	36						
13												

I, M.P. DAVIS, in a field survey on OCTOBER, 19 97, do hereby certify that under requirements of P.A. 74, Michigan P.A. of 1970, the corner points mentioned in lines 1 and 2 above were in conformance with regulations and rules therefore as required in the current manual of survey instructions of the United States Department of the Interior, Bureau of Land Management or by a decree of a Court of Law and/or that the corner points mentioned in lines 3, 4 and 5 above were in conformance with the rules of the Michigan Board of Land Surveyors or by a Decree of a Court of Law; established, re-established, monumented, re-monumented, recovered, found as expressed below:

NOTE: Not more than 4 corners, all in the same town and range, may be recorded on this certificate.


A. Description of original monument and accessories and/or subsequent restoration:
A-05 [NW COR SEC 18] JOHN BURT, DS - 1845 - WOOD POST - (TAMARACK 12"-S64°W-20 LINKS)(SPRUCE 06"-N74°W 36 LINKS) E.C.MARTIN, DS - 1852 - (SPRUCE 08"-S52°E-18 LINKS)(TAMARACK 14" N26°E-22 LINKS) FROM SURVEY OF T42N R22W E.C.MARTIN, DS - 1852 - (FIR 14"-S60°W-21 LINKS) FROM SURVEY OF T42N R23W NO RECORD EVIDENCE OF CORNER RECOVERY AND/OR SUBSEQUENT CORNER MONUMENTATION.

A-06 [W1/4 COR SEC 18] JOHN BURT DS - 1845 - (CEDAR 09"-S20°W-12 LINKS)(CEDAR 08"-N35°W-30 LINKS) NO RECORD EVIDENCE OF CORNER RECOVERY AND/OR SUBSEQUENT MONUMENTATION

B. Description of corner evidence found and/or method applied in restoring or reestablishing corner:

A-05 [NW COR SEC 18] NO CORNER EVIDENCE FOUND. REESTABLISHED CORNER POSITION BY SINGLE PROPORTIONAL DISTANCE BETWEEN & ON LINE WITH THE NW CORNER OF SECTION 6 & THE NW CORNER OF SECTION 31 T42N R22W., WHICH FALLS S50°E 106' FROM CHAMPION TIMBER COMPANY'S WOOD POST & LOCATOR TAG.

A-06 [W1/4 COR SEC 18] NO CORNER EVIDENCE FOUND. ESTABLISHED CORNER POSITION ON LINE WITH AND AT MIDPOINT BETWEEN SECTION CORNERS 1/2 MILE NORTH & SOUTH, WHICH FALLS S50°E 54' FROM CHAMPION TIMBER COMPANY'S WOOD POST & LOCATOR TAG.

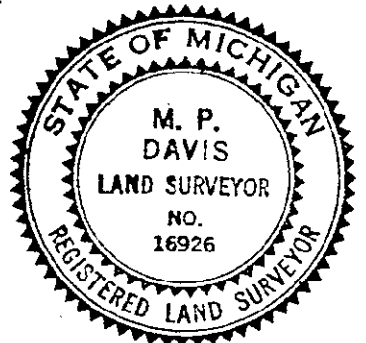

C. Description of monument for corner and accessories established to perpetuate locating the position of the corner:

A-05 SET A BERNTSEN A1NB30 ALUM MONUMENT WITH THE CAP STAMPED TO ID THE CORNER POSITION.
CEDAR 10" CEDAR 07" CEDAR 06" CEDAR 08" SURVEY MONUMENT SIGN POST
N15°W N59°E S38°E N82°W SOUTH
12.28' 11.96' 13.10' 05.06' 2.51' (TO FACE)

A-06 SET A BERNTSEN A1NB30 ALUM MONUMENT WITH THE CAP STAMPED TO ID THE CORNER POSITION.
CEDAR 15" CEDAR 09" MAPLE 12" CEDAR 09" SURVEY MONUMENT SIGN POST
N05°W S88°E S12°W S84°W S45°E
16.12' 19.63' 28.20' 21.57' 2.00' (TO FACE)

NOTE: BEARINGS TO REFERENCE OBJECTS ARE MAGNETIC & DISTANCES ARE TO A NAIL W/A REFERENCE TAG UNLESS OTHERWISE NOTED.

Signed by M.P. Davis Date 11/29/97
Surveyor's Michigan License No. 16926