

**SURVEY & REMONUMENTATION**

**JAN 14 1998**

**SECTION**

**LAND CORNER RECORDATION CERTIFICATE**  
**Filing Requirement of Act 74, Mich. P.A. 1970**

Approved By Delta County  
 Land Survey Remonumentation  
 Peer Group Under Act 345 Of  
 P.A. Of 1990 On 12/18, 1997  
*Robert Schmelzig*  
 Acting Chairman

For corners in  
DELTA  
 (County)

Located In: Corner Code #

1. Public Land Survey	T <u>42 N</u> R <u>22 W</u>	<u>A-07 &amp; A-08</u>
	T <u>42 N</u> R <u>23 W</u>	<u>M-07 &amp; M-08</u>
	T _____ R _____	_____
	T _____ R _____	_____
2. Property Controlling in Section	S _____ T _____ R _____	_____
	S _____ T _____ R _____	_____
3. Miscellaneous Property in Sec.	S _____ T _____ R _____	_____
	S _____ T _____ R _____	_____

Dec 19 1997  
9:00 AM  
8 285  
*Wallace C. Thomas*

Register of Deeds Stamp & File Number

4. Lot No. \_\_\_\_\_, Recorded Plat \_\_\_\_\_  
 5. Private Claims  
A-07 [NW SEC 19] A-08 [W1/4 SEC 19] SAME CORNERS AS M-07, M-08

A	B	C	D	E	F	G	H	I	J	K	L	M
2	6	5	4	3	2	1						
3												
4	7	8	9	10	11	12						
5												
6	18	17	16	15	14	13						
7												
8	19	20	21	22	23	24						
9												
10	30	29	28	27	26	25						
11												
12	31	32	33	34	35	36						
13												

I, M.P. DAVIS, in a field survey on OCTOBER, 19 97, do hereby certify that under requirements of P.A. 74, Michigan P.A. of 1970, the corner points mentioned in lines 1 and 2 above were in conformance with regulations and rules therefore as required in the current manual of survey instructions of the United States Department of the Interior, Bureau of Land Management or by a decree of a Court of Law and/or that the corner points mentioned in lines 3, 4 and 5 above were in conformance with the rules of the Michigan Board of Land Surveyors or by a Decree of a Court of Law; established, re-established, monumented, re-monumented, recovered, found as expressed below:

**NOTE: Not more than 4 corners, all in the same town and range, may be recorded on this certificate.**

**A. Description of original monument and accessories and/or subsequent restoration:**


A-07 [NW COR SEC 19] JOHN BURT, DS - 1845 - WOOD POST - (CEDAR 08'-S57°W-15 LINKS)(Y.BIRCH 16"-N22°W 22 LINKS)  
 E.C.MARTIN, DS - 1852 - (CEDAR 10"-S45°E-43 LINKS)(CEDAR 14" N80°E-11 LINKS) FROM SURVEY OF T42N R22W  
 E.C.MARTIN, DS - 1852 - (CEDAR 10"-S46°W-16 LINKS) FROM SURVEY OF T42N R23W  
 NO RECORD EVIDENCE OF CORNER RECOVERY AND/OR SUBSEQUENT CORNER MONUMENTATION.

A-08 [W1/4 COR SEC 19] JOHN BURT DS - 1845 - (HEMLOCK 18'-S62°E-15 LINKS)(SUGAR 18"-N46°W-32 LINKS)  
 NO RECORD EVIDENCE OF CORNER RECOVERY AND/OR SUBSEQUENT MONUMENTATION

**B. Description of corner evidence found and/or method applied in restoring or reestablishing corner:**

A-07 [NW COR SEC 19] NO CORNER EVIDENCE FOUND. REESTABLISHED CORNER POSITION BY SINGLE PROPORTIONAL DISTANCE BETWEEN & ON LINE WITH THE NW CORNER OF SECTION 6 & THE NW CORNER OF SECTION 31 T42N R22W., WHICH FALLS S55°E 66' FROM CHAMPION TIMBER COMPANY'S WOOD POST & LOCATOR TAG.

A-08 [W1/4 COR SEC 19] NO CORNER EVIDENCE FOUND. ESTABLISHED CORNER POSITION ON LINE WITH AND AT MIDPOINT BETWEEN SECTION CORNERS 1/2 MILE NORTH & SOUTH, WHICH FALLS S58°E 58.5' FROM CHAMPION TIMBER COMPANY'S WOOD POST & LOCATOR TAG.

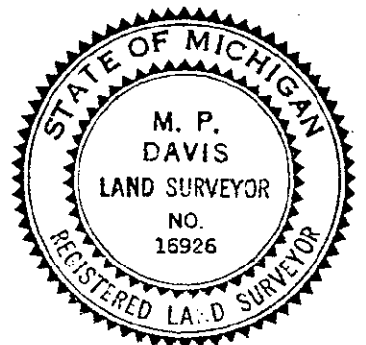

**C. Description of monument for corner and accessories established to perpetuate locating the position of the corner:**

A-07 SET A BERNTSEN AINB30 ALUM MONUMENT WITH THE CAP STAMPED TO ID THE CORNER POSITION.  
 CEDAR 11' CEDAR 05' CEDAR 10' CEDAR 06" SURVEY MONUMENT SIGN POST  
 N31°W N88°E S33°E S64°W NORTH  
 02.42' 01.85' 17.55' 15.28' 4.63' (TO FACE)

A-08 SET A BERNTSEN AINB30 ALUM MONUMENT WITH THE CAP STAMPED TO ID THE CORNER POSITION.  
 MAPLE 10" MAPLE 15" MAPLE 10" MAPLE 11" SURVEY MONUMENT SIGN POST  
 N47°W N53°E S55°E S52°W SOUTH  
 32.28' 16.61' 28.07' 27.80' 1.95' (TO FACE)

NOTE: BEARINGS TO REFERENCE OBJECTS ARE MAGNETIC & DISTANCES ARE TO A NAIL W/A REFERENCE TAG UNLESS OTHERWISE NOTED.

Signed by M.P. Davis Date 11/28/97  
 Surveyor's Michigan License No. 16926