

# SURVEY & REMONUMENTATION

JAN 14 1998

## LAND CORNER RECORDATION CERTIFICATE Filing Requirement of Act 74, Mich. P.A. 1970

Approved By Delta County  
Land Survey Remonumentation  
Peer Group Under Act 345 Of  
P.A. Of 1990 On 12/18, 1992

*Robert B. Schmeling*  
Acting Chairman

For corners in SECTION  
DELTA  
(County)

Located In: Corner Code ##

- |                                    |   |    |   |   |    |   |             |
|------------------------------------|---|----|---|---|----|---|-------------|
| 1. Public Land Survey              | T | 42 | N | R | 22 | W | A-01 & A-02 |
|                                    | T | 43 | N | R | 22 | W | A-13        |
|                                    | T | 42 | N | R | 23 | W | M-01 & M-02 |
|                                    | T | 43 | N | R | 23 | W | M-13        |
| 2. Property Controlling in Section | S |    | T |   | R  |   |             |
| 3. Miscellaneous Property in Sec.  | S |    | T |   | R  |   |             |

Dec 19 1997  
9:00 AM  
8 Page 291  
*Walter C. Thomas*  
Delta County Reg. of Deeds

Register of Deeds Stamp & File Number

4. Lot No. \_\_\_\_\_, Recorded Plat \_\_\_\_\_  
5. Private Claims \_\_\_\_\_  
A-01 [NW SEC 6] A-02 [W1/4 SEC 6] A-01, A-13, M-01, M-13 ARE SAME CORNER

	A	B	C	D	E	F	G	H	I	J	K	L	M
2	6	5	4	3	2	1							
3													
4	7	8	9	10	11	12							
5													
6	13	17	16	15	14	13							
7													
8	19	20	21	22	23	24							
9													
10	30	29	28	27	26	25							
11													
12	31	32	33	34	35	36							
13													

I, M.P. DAVIS, in a field survey on OCTOBER, 19 97, do hereby certify that under requirements of P.A. 74, Michigan P.A. of 1970, the corner points mentioned in lines 1 and 2 above were in conformance with regulations and rules therefore as required in the current manual of survey instructions of the United States Department of the Interior, Bureau of Land Management or by a decree of a Court of Law and/or that the corner points mentioned in lines 3, 4 and 5 above were in conformance with the rules of the Michigan Board of Land Surveyors or by a Decree of a Court of Law; established, re-established, monumented, re-monumented, recovered, found as expressed below:

**NOTE: Not more than 4 corners, all in the same town and range, may be recorded on this certificate.**


A. Description of original monument and accessories and/or subsequent restoration:  
A-01 [NW COR SEC 6] WM. BURT, DS - 1841 - WOOD POST - (SUGAR 18"-N59°E-09 LINKS)(SUGAR 26"-S36°W787 LINKS)  
D.A.BROTHERTON-1910-ID BY REMAINS OF ORIG SUGAR SW & WIT'S TREE SE  
M.S.McNABB-1921-ID FROM REMAINS OF ORIGINALS NOW NEW WIT'S NOTED  
M.S.McNABB-1929-ID FROM PREVIOUS SURVEY, SET IRON STAKE (MAPLE STUMPS 24" N27°W 66.8' & N75°E 5.5')

A-02 [W1/4 COR SEC 6] JOHN BURT DS - 1845 - TAMARACK 8" CORNER TREE (TAMARACK 04'-S10°E-04 LINKS)  
NO RECORD EVIDENCE OF CORNER RECOVERY AND/OR SUBSEQUENT MONUMENTATION

B. Description of corner evidence found and/or method applied in restoring or reestablishing corner:

A-01 [NW COR SEC 6] FOUND IN PLACE McNABB'S 3/4" IRON PIPE, NO EVIDENCE OF HIS MAPLE STUMP BT'S. DISTANCE EAST & NORTH TO ADJOINING CORNERS CHECK WELL WITH THE RECORDS OF McNABB EAST FROM THE N-S 1/4 LINE OF SEC 6. ACCEPTED THIS LOCATION AS BEING A CAREFUL AND FAITHFUL PERPETUATION OF THE POSITION OF THE ORIGINAL CORNER.

A-02 [W1/4 COR SEC 6] NO CORNER EVIDENCE FOUND. ESTABLISHED CORNER POSITION ON LINE WITH AND PROPORTIONAL DISTANCE BETWEEN SECTION CORNERS 1/2 MILE NORTH & SOUTH.

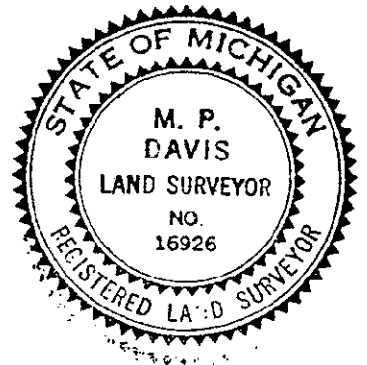

C. Description of monument for corner and accessories established to perpetuate locating the position of the corner:

A-01 SET, OVER EXISTING MONUMENT A BERNTSEN ALN830 ALUM MONUMENT WITH THE CAP STAMPED TO ID THE CORNER POSITION.  
BASSWOOD 12" MAPLE 10" U.S.G.S BM DISK T1101S SURVEY MONUMENT SIGN POST  
N02°E S40°E N68°E S73°W  
70.89' 44.60' 30.42' 1.65' (TO FACE)

A-02 SET A BERNTSEN ALN830 ALUM MONUMENT WITH THE CAP STAMPED TO ID THE CORNER POSITION.  
CEDAR 06" CEDAR 10" CEDAR 10" SURVEY MONUMENT SIGN POST  
N76°W N18°E S23°W S40°E  
37.16' 7.50' 10.88' 3.08' (TO FACE)

**NOTE: BEARINGS TO REFERENCE OBJECTS ARE MAGNETIC & DISTANCES ARE TO A NAIL W/A REFERENCE TAG UNLESS OTHERWISE NOTED.**

Signed by M.P. Davis Date 11/28/97  
Surveyor's Michigan License No. 16926