

184

LAND CORNER RECORDATION CERTIFICATE
Filing Requirement of Act 74, Mich. P.A. 1970

For corners in

Delta (County) Located In: Corner Code //
1. Public Land Survey T 43N R 22W L-5, L-6, M-5, M-6
2. Property Controlling in Section S T R
3. Miscellaneous Property in Sec. S T R
4. Lot No. , Recorded Plat
5. Private Claims

Register of Deeds Stamp & File Number

Grid table with columns A-M and rows 2-13. Contains numbers 1-36 and symbols indicating corner locations.

I, Paul R. Bressette, in a field survey on September-October, 1994, do hereby certify that under requirements of P.A. 74, Michigan P.A. of 1970, the corner points mentioned in lines 1 and 2 above were in conformance with regulations and rules therefore as required in the current manual of survey instructions of the United States Department of the Interior, Bureau of Land Management or by a decree of a Court of Law and/or that the corner points mentioned in lines 3, 4 and 5 above were in conformance with the rules of the Michigan Board of Land Surveyors or by a Decree of a Court of Law; established, re-established, monumented, re-monumented, recovered, found as expressed below:

NOTE: Not more than 4 corners, all in the same town and range, may be recorded on this certificate.

A. Description of original monument and accessories and/or subsequent restoration:


- L-5. Quarter Corner common to Sections 12 and 13. 1971: Frank Bray, RLS. Set 1" iron pipe with aluminum cap witnessed by: 7" Cedar S79W 25.3'; 9" Hemlock S40W 6.2'.
L-6. Center Quarter Corner of Section 13. Not set in original survey, no evidence of subsequent establishment.
M-5. Section Corner common to Sections 12, 13, 7, and 18. 1841: W.A. Burt, D.S. Set wood post witnessed by: Sugar 14 S17W 28 links; Sugar 14 N17E 20 links. Two witnesses were added during subdivision of the townships: Sugar 18 S10E 47 links; Sugar 10 N20W 30 links.
M-6. Quarter Corner common to Sections 13 and 18. 1841: W.A. Burt, D.S. Set wood post witnessed by: Hemlock 12 S30W 19 links; Hemlock 12 N56E 43 links.

B. Description of corner evidence found and/or method applied in restoring or reestablishing corner:

- L-5. Found Bray's NBT's alive and standing. Monument had been moved about 33 feet to the south and the cap was broken. Set new monument in proper position from NBT's and marked two witnesses.
L-6. Corner position established at the intersection of the north-south and east-west quarter lines of Section 13.
M-5. No evidence of original or subsequent restoration found. Found old fence intersection with ancient fences in all four directions. Distance north 2651.76 feet (GLO-40.00 ch); distance south 5228.34 feet (GLO-80.00 ch); distance west 2706.26 feet (GLO-40.35 ch). The original notes show a wide range of variation on the east line of S.13 and contain a note "These extraordinary aberration of the needle were counteracted as near as could be judged by corresponding changes in the course between stations as the line could not be run without the aid of the needle on the account of thickness of the forest probably the line is curved between stations". During subdivision, the random line between S.12 and S.13 intersected the township line 178 links north of the corner. With this in mind, I accepted the fence (over)

C. Description of monument for corner and accessories established to perpetuate locating the position of the corner:

Table with 4 columns: L-5. DNR monument, L-6. DNR monument, M-5. DNR monument, M-6. DNR monument. Lists monument types and measurements for each corner.

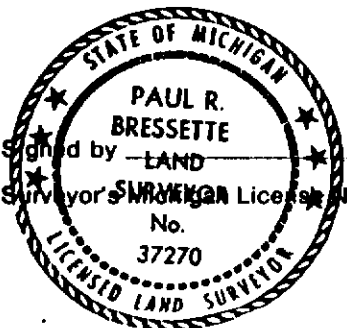

Paul R. Bressette Date
37270