

Approved By Delta County  
 Land Survey Remonumentation  
 Peer Group Under Act 345 Of  
 P.A. Of 1990 On May 12, 1994  
*Robert Schmeling*  
 Delta Chairman


**LAND CORNER RECORDATION CERTIFICATE**  
 Filing Requirement of Act 74, Mich. P.A. 1970

For corners in

DELTA  
 (County)

Located In:

Corner Code ##

- |                                    |                             |   |
|------------------------------------|-----------------------------|---|
| 1. Public Land Survey              | T <u>43</u> N R <u>23</u> W |  |
|                                    | T _____ R _____             | _____   |
|                                    | T _____ R _____             | _____   |
|                                    | T _____ R _____             | _____   |
| 2. Property Controlling in Section | S _____ T _____ R _____     | _____   |
|                                    | S _____ T _____ R _____     | _____   |
| 3. Miscellaneous Property in Sec.  | S _____ T _____ R _____     | _____   |
|                                    | S _____ T _____ R _____     | _____   |

MAY 13 1994

Recorded \_\_\_\_\_  
 at 9:00 o'clock AM in Libor 7 Page 400  
*William C. Thuman* Reg. of Deeds.  
 Delta County, Michigan  
 Register of Deeds Stamp & File Number

4. Lot No. \_\_\_\_\_, Recorded Plat \_\_\_\_\_  
 5. Private Claims \_\_\_\_\_

E-10 [W1/4 COR SEC 28] F-9 [N1/4 COR SEC 28]

I, M. P. DAVIS, in a field survey on FEBRUARY, 19 94, do hereby certify that under requirements of P.A. 74, Michigan P.A. of 1970, the corner points mentioned in lines 1 and 2 above were in conformance with regulations and rules therefore as required in the current manual of survey instructions of the United States Department of the Interior, Bureau of Land Management or by a decree of a Court of Law and/or that the corner points mentioned in lines 3, 4 and 5 above were in conformance with the rules of the Michigan Board of Land Surveyors or by a Decree of a Court of Law; established, re-established, monumented, re-monumented, recovered, found as expressed below:

A	B	C	D	E	F	G	H	I	J	K	L
2	6	5	4	3	2	1					
3											
4	7	8	9	10	11	12					
5											
6	18	17	16	15	14	13					
7											
8	19	20	21	22	23	24					
9											
10	30	29	28	27	26	25					
11											
12	31	32	33	34	35	36					
13											


**NOTE: Not more than 4 corners, all in the same town and range, may be recorded on this certificate.**

A. Description of original monument and accessories and/or subsequent restoration:

- E-10 [W1/4 COR SEC 28] MARTIN M. HALL, D.S. - 1853 - CEDAR POST (TAMARACK 14°-N62°E-34 LINKS) (CEDAR 08°-S66°W-33 LINKS)  
 J.E. GINGRASS - 1912 - STAKE IN PLACE - NO NEW WIT'S NOTED
- F-9 [N1/4 COR SEC 28] MARTIN M. HALL, D.S. - 1853 - SPRUCE POST (SPRUCE 10°-S42°E-126 LINKS) (TAMARACK 16°-N51°W-73 LINKS)  
 J.E. GINGRASS - 1912 - STAKE IN PLACE - ID FROM "BEARINGS" (ASSUMED ORIGINALS ? M.D.) - NO NEW WIT'S NOTED  
 M.D.O.T. - 1955 - ALIGNMENT SURVEY FOR HWY M-35 IDENTIFIED CORNER POSITION BY WOOD POST IN PLACE.

B. Description of corner evidence found and/or method applied in restoring or reestablishing corner:

- E-10 [W1/4 COR SEC 28] NO EVIDENCE OF GINGRASS CORNER MONUMENT FOUND. ESTABLISHED NEW COR POSITION BY RETRACEMENT OF GINGRASS'S E-W 1/4 LINE. EXTENDED LINE WEST FROM E1/4 COR THRU JCT OF FENCE LINES AT THE C1/4 & AT THE FENCE COR AT THE CW1/16 POSITION & ESTABLISHED THE W1/4 ON THIS LINE AT A PROPORTIONATE DISTANCE WEST OF THE W1/16 COR. THE DISTANCE FROM THE C1/4 COR FENCE & W1/16 FENCE MATCH WELL WITH THE GINGRASS SURVEY AS DO THE DISTANCES FROM THE N & S 1/4 CORNERS TO THE C1/4 COR FENCE. ACCEPTED AS BEING THE BEST AVAILABLE EVIDENCE AS TO POSITION OF THE ORIGINAL CORNER.
- F-9 [N1/4 COR SEC 28] FOUND REMAINS OF GINGRASS'S WOOD POST - ID SAME FROM M.D.O.T. TIES TO THE C/L OF HWY. M-35. ACCEPTED EXISTING MONUMENT AS BEING A CAREFULL & FAITHFUL PERPETUATION OF THE POSITION OF THE ORIGINAL CORNER.

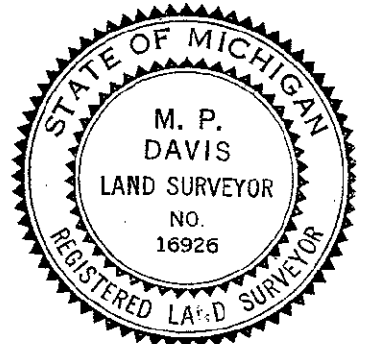

C. Description of monument for corner and accessories established to perpetuate locating the position of the corner:

- E-10 SET BERNTSEN AINB30 ALUMN MON WITH THE CAP STAMPED TO ID THE CORNER POSITION.  
 TAMARACK 9" TAMARACK 8" SPRUCE SURVEY MONUMENT SIGN POST  
 N20°W S50°E N40°E WEST  
 16.39' 26.48' 18.70' 1.27' (TO FACE)
- F-9 SET BERNTSEN AINB30 ALUMN MONUMENT WITH THE CAP STAMPED TO ID THE CORNER POSITION.  
 TAMARACK 9" TAMARACK 9" SURVEY MONUMENT SIGN POST  
 N38°W S41°W N45°W  
 45.05' 40.42' 1.95' (TO FACE)

NOTE: BEARINGS TO REFERENCE OBJECTS ARE MAGNETIC & DISTANCES ARE TO A NAIL W/A REFERENCE TAG, UNLESS NOTED OTHERWISE.

Signed by M. P. Davis Date 5/6/94  
 Surveyor's Michigan License No. 16926