

# SURVEY & REMONUMENTATION

JAN 14 1998

Approved By Delta County  
Land Survey Remonumentation  
Peer Group Under Act 345 Of  
P.A. Of 1990 On 12/18, 1997

## LAND CORNER RECORDATION CERTIFICATE

Filing Requirement of Act 74, Mich. P.A. 1970

Robert E. Schmeling  
acting Chairman

### SECTION

For corners in  
DELTA  
(County)

Located In: Corner Code #/

- |                                    |               |               |                        |
|------------------------------------|---------------|---------------|------------------------|
| 1. Public Land Survey              | T <u>43 N</u> | R <u>23 W</u> | <u>K-03 &amp; K-04</u> |
|                                    | T _____       | R _____       | _____                  |
|                                    | T _____       | R _____       | _____                  |
|                                    | T _____       | R _____       | _____                  |
| 2. Property Controlling in Section | S _____       | T _____       | R _____                |
|                                    | S _____       | T _____       | R _____                |
| 3. Miscellaneous Property in Sec.  | S _____       | T _____       | R _____                |
|                                    | S _____       | T _____       | R _____                |

Recorded Dec 19 1997  
at 9:00 AM  
for 8 pgs 266

Register of Deeds Stamp & File Number

4. Lot No. \_\_\_\_\_, Recorded Plat \_\_\_\_\_
5. Private Claims K-03 [NW COR SEC 12] K-04 [W1/4 COR SEC 12]


	A	B	C	D	E	F	G	H	I	J	K	L	M
2	6	5	4	3	2	1							
3											●		
4	7	8	9	10	11	12					●		
5													
6	18	17	16	15	14	13							
7													
8	19	20	21	22	23	24							
9													
10	30	29	28	27	26	25							
11													
12	31	32	33	34	35	36							
13													

I, M.P. DAVIS, in a field survey on NOVEMBER, 19 97, do hereby certify that under requirements of P.A. 74, Michigan P.A. of 1970, the corner points mentioned in lines 1 and 2 above were in conformance with regulations and rules therefore as required in the current manual of survey instructions of the United States Department of the Interior, Bureau of Land Management or by a decree of a Court of Law and/or that the corner points mentioned in lines 3, 4 and 5 above were in conformance with the rules of the Michigan Board of Land Surveyors or by a Decree of a Court of Law; established, re-established, monumented, re-monumented, recovered, found as expressed below:

**NOTE: Not more than 4 corners, all in the same town and range, may be recorded on this certificate.**

- A. Description of original monument and accessories and/or subsequent restoration:
- K-03 [NW COR SEC 12] M.M.HALL, DS - 1853 - WOOD POST - TOP OF RIDGE 15' E & W (W.PINE 30"-N36°W-43 LINKS)(FIR 11"-S43°E-55 LINKS)  
NO RECORD EVIDENCE OF CORNER RECOVERY AND/OR SUBSEQUENT MONUMENTATION
- K-04 [W1/4 COR SEC 12] M.M.HALL, DS - 1853 - WOOD POST - (HEMLOCK 10"-S48°W-15 LINKS) (HEMLOCK 18"-N34°E-30 LINKS)  
NO RECORD EVIDENCE OF CORNER RECOVERY AND/OR SUBSEQUENT MONUMENTATION

- B. Description of corner evidence found and/or method applied in restoring or reestablishing corner:
- K-03 [NW COR SEC 12] FOUND IN PLACE A "OLIVER IRON MINING COMPANY" SURVEY MONUMENT (2" I.P. W/A 3" BRASS CAP) STAMPED TO ID THE CORNER POSITION, NO DATE SHOWN. NO EVIDENCE OF "GLO" OR SUBSEQUENT BT'S. "GLO" POSITION CALLS FOR THIS CORNER TO BE LOCATED ON A 15' HIGH RIDGE, EXAMINATION OF THE SURROUNDING TERRAIN FOR SOME DISTANCE AROUND THE EXISTING MONUMENT DID NOT REVEAL A RIDGE OF THE MAGNITUDE AS DESCRIBED IN THE ORIGINAL SURVEY. ACCEPTED EXISTING MONUMENT AS BEING THE BEST AVAILABLE EVIDENCE AS TO THE POSITION OF THE ORIGINAL CORNER.
- K-04 [W1/4 COR SEC 12] FOUND IN PLACE A "OLIVER IRON MINING COMPANY" SURVEY MONUMENT (2" I.P. W/A 3" BRASS CAP) STAMPED TO ID THE CORNER POSITION, NO DATE SHOWN. NO EVIDENCE OF "GLO" OR SUBSEQUENT BT'S. ACCEPTED EXISTING MONUMENT AS BEING THE BEST AVAILABLE EVIDENCE AS TO THE POSITION OF THE ORIGINAL CORNER.

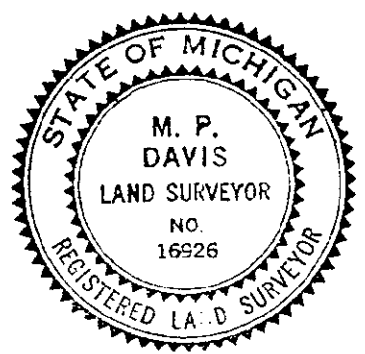

- C. Description of monument for corner and accessories established to perpetuate locating the position of the corner:

K-03 DID NOT DISTURB EXISTING MONUMENT

MAPLE 12"	BALSAM 12"	BALSAM 08"	SURVEY MONUMENT SIGN POST
N52°W	S54°W	S20°E	EAST
4.73'	38.17'	26.85'	3.39' (TO FACE)

K-04 DID NOT DISTURB EXISTING MONUMENT

BALSAM 07"	SPRUCE 04"	MAPLE 07"	SURVEY MONUMENT SIGN POST
EAST	S05°W	N52°W	NORTH
8.88'	13.25'	14.08'	1.60' (TO FACE)

NOTE: BEARINGS TO REFERENCE OBJECTS ARE MAGNETIC & DISTANCES ARE TO A NAIL W/A REFERENCE TAG IN THE OBJECT UNLESS OTHERWISE NOTED.

Signed by M.P. Davis Date 11/21/97

Surveyor's Michigan License No. 16926