

SURVEY & REMONUMENTATION

JAN 14 1998

Approved By Delta County
Land Survey Remonumentation
Peer Group Under Act 345 Of
P.A. Of 1990 On 12/18, 1992

SECTION LAND CORNER RECORDATION CERTIFICATE

Filing Requirement of Act 74, Mich. P.A. 1970

Robert Schmeling
Acting Chairman

For corners in
DELTA
(County)

Located In: Corner Code #

1. Public Land Survey	T <u>43</u> N R <u>23</u> W	<u>L-03 & L-05</u>
	T _____ R _____	_____
	T _____ R _____	_____
	T _____ R _____	_____
2. Property Controlling in Section	S _____ T _____ R _____	_____
	S _____ T _____ R _____	_____
3. Miscellaneous Property in Sec.	S _____ T _____ R _____	_____
	S _____ T _____ R _____	_____

Done Dec 19 1997
9:00 AM
8 pm 265

Register of Deeds Stamp & File Number

4. Lot No. _____, Recorded Plat _____
5. Private Claims L-03 [N1/4 COR SEC 12] L-05 [N1/4 COR SEC 13]

A	B	C	D	E	F	G	H	I	J	K	L	M
2	6	5	4	3	2	1						
3												
4	7	8	9	10	11	12						
5												
6	18	17	16	15	14	13						
7												
8	19	20	21	22	23	24						
9												
10	30	29	28	27	26	25						
11												
12	31	32	33	34	35	36						
13												

I, M.P. DAVIS, in a field survey on NOVEMBER, 19 97, do hereby certify that under requirements of P.A. 74, Michigan P.A. of 1970, the corner points mentioned in lines 1 and 2 above were in conformance with regulations and rules therefore as required in the current manual of survey instructions of the United States Department of the Interior, Bureau of Land Management or by a decree of a Court of Law and/or that the corner points mentioned in lines 3, 4 and 5 above were in conformance with the rules of the Michigan Board of Land Surveyors or by a Decree of a Court of Law; established, re-established, monumented, re-monumented, recovered, found as expressed below:

NOTE: Not more than 4 corners, all in the same town and range, may be recorded on this certificate.

A. Description of original monument and accessories and/or subsequent restoration:


L-03 [N1/4 COR SEC 12] M.M.HALL, DS - 1853 - WOOD POST - (HEMLOCK 14°-N80°E-40 LINKS)(FIR 05°-S76°W-30 LINKS)
NO RECORD EVIDENCE OF CORNER RECOVERY AND/OR SUBSEQUENT MONUMENTATION

L-05 [N1/4 COR SEC 13] M.M.HALL, DS - 1853 - WOOD POST - (HEMLOCK 16°-N60°E-17 LINKS) (BLACK ASH 12°-S44°W-25 LINKS)
NO RECORD EVIDENCE OF CORNER RECOVERY AND/OR SUBSEQUENT MONUMENTATION

B. Description of corner evidence found and/or method applied in restoring or reestablishing corner:

L-03 [N1/4 COR SEC 12] NO CORNER EVIDENCE FOUND. REESTABLISHED CORNER POSITION ON LINE WITH AND AT MIDPOINT BETWEEN SECTION CORNERS 1/2 MILE EAST & WEST. THIS POSITION GIVES BEST FIT TO COUNTY ROAD IMPROVEMENTS EAST AND SOUTH.

L-05 [N1/4 COR SEC 13] NO CORNER EVIDENCE FOUND. REESTABLISHED CORNER POSITION ON LINE WITH SECTION CORNERS 1/2 MILE EAST & WEST AND IN LINE WITH ANCIENT FENCE LINE (DOWN & IN POOR REPAIR) TO THE SOUTH. ACCEPTED AS BEING THE BEST AVAILABLE EVIDENCE AS TO THE POSITION OF THE ORIGINAL CORNER.

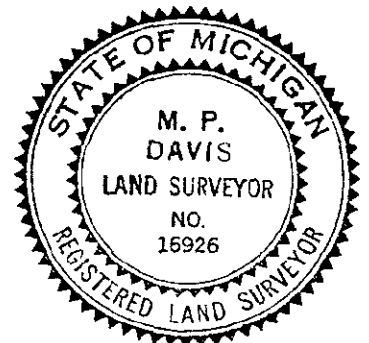

C. Description of monument for corner and accessories established to perpetuate locating the position of the corner:

L-03 SET A BERNTSEN A1NB30 ALUM MONUMENT WITH THE CAP STAMPED TO ID THE CORNER POSITION.

SPRUCE 09"	W.PINE 23"	MAPLE 08"	SURVEY MONUMENT SIGN POST
S40°E	N40°E	N75°W	NORTH
86.98'	47.26'	41.38'	2.63' (TO FACE)

L-05 SET, 4" BELOW GRADE, A 5/8" X 18" REBAR W/A 3/4" ALUM CAP STAMPED TO ID THE CORNER POSITION.

BALSAM 07"	SPRUCE 06"	MAPLE 11"	MAPLE 05"
S68°E	N45°E	S42°E	N45°W
48.08'	45.87'	74.54'	87.64'

NOTE: BEARINGS TO REFERENCE OBJECTS ARE MAGNETIC & DISTANCES ARE TO A NAIL W/A REFERENCE TAG IN THE OBJECT UNLESS OTHERWISE NOTED.

Signed by M.P. Davis Date 11/29/97

Surveyor's Michigan License No. 16926