

*Walter C. Thomas*  
Chairman

JAN 26 2000

LAND CORNER RECORDATION CERTIFICATE  
Filing Requirement of Act 74, Mich. P.A. 1970

SECTION  
For corners in

|                                       |                   |               |
|---------------------------------------|-------------------|---------------|
| <u>DELTA</u><br>(County)              | Located in:       | Corner Code # |
| 1. Public Land Survey                 | T 43 NR 20 W      | M-03 SAME     |
|                                       | T 43 NR 19 W      | A-03 CORNER   |
|                                       | T 43 NR 20 W      | M-04 SAME     |
|                                       | T 43 NR 19 W      | A-04 CORNER   |
| 2. Property Controlling<br>in Section | S ___ T ___ R ___ | _____         |
|                                       | S ___ T ___ R ___ | _____         |
| 3. Miscellaneous<br>Property in Sec.  | S ___ T ___ R ___ | _____         |
|                                       | S ___ T ___ R ___ | _____         |

01-04-00  
2:00 P.M.  
9 PAGE 195  
*Walter C. Thomas*

Register of Deeds Stamp & File Number

4. Lot No. \_\_\_\_\_ Recorded Plat \_\_\_\_\_  
5. Private Claims \_\_\_\_\_

I, M.P. DAVIS, in a field survey on DECEMBER, 19 99 do hereby state that under requirements of P.A. 74, Michigan P.A. of 1970, the corner points mentioned in lines 1 and 2 above were in conformance with regulations and rules therefore as required in the current manual of survey instructions of the United States Department of the Interior, Bureau of Land Management or by a decree of a Court of Law and/or that the corner points mentioned in lines 3, 4 and 5 above were in conformance with the rules of the Michigan Board of Land Surveyors or by a Decree of a Court of Law; established, re-established, monumented, recovered, found as expressed below:

| A  | B  | C  | D  | E  | F  | G  | H | I | J | K | L | M |
|----|----|----|----|----|----|----|---|---|---|---|---|---|
| 1  |    |    |    |    |    |    |   |   |   |   |   |   |
| 2  | 6  | 5  | 4  | 3  | 2  | 1  |   |   |   |   |   |   |
| 3  |    |    |    |    |    |    |   |   |   |   |   |   |
| 4  | 7  | 8  | 9  | 10 | 11 | 12 |   |   |   |   |   |   |
| 5  |    |    |    |    |    |    |   |   |   |   |   |   |
| 6  | 18 | 17 | 16 | 15 | 14 | 13 |   |   |   |   |   |   |
| 7  |    |    |    |    |    |    |   |   |   |   |   |   |
| 8  | 19 | 20 | 21 | 22 | 23 | 24 |   |   |   |   |   |   |
| 9  |    |    |    |    |    |    |   |   |   |   |   |   |
| 10 | 30 | 29 | 28 | 27 | 26 | 25 |   |   |   |   |   |   |
| 11 |    |    |    |    |    |    |   |   |   |   |   |   |
| 12 | 31 | 32 | 33 | 34 | 35 | 36 |   |   |   |   |   |   |
| 13 |    |    |    |    |    |    |   |   |   |   |   |   |


NOTE: Not more than 2 corners, all in the same town and range, may be recorded on this certificate.

A. Description of original monument and accessories and/or subsequent restoration:

- M-03 [NE COR SEC 12] Wm. BURT, D.S.-1841-WOOD POST (SPRUCE 08" N65°E 25 LINKS)(PINE 09" N80°W 19 LINKS)  
A.MERRYWEATHER, D.S.-1849-CORNER IN PLACE (HEMLOCK 08" S35°E 20 LINKS)(SPRUCE 09" N71°E 25 LINKS)  
BAY DE NOC LUMBER COMPANY-DATE UNKNOWN-MAP OF THE UNRECORDED PLAT OF ROUND LAKE SHOWS CORNER IN PLACE, NO DESCRIPTION GIVEN
- M-04 [E1/4 COR SEC 12] Wm BURT, D.S. 1841-WOOD POST (SPRUCE 06" N45°E 20 LINKS)(SPRUCE 06" N20°W 22 LINKS)  
NO RECORD EVIDENCE OF CORNER RECOVERY AND/OR SUBSEQUENT MONUMENTATION.

B. Description of corner evidence found and/or method applied in restoring or reestablishing corner:

- M-03 [NE COR SEC 12] NO CORNER EVIDENCE FOUND - REESTABLISHED CORNER POSITION ON LINE WITH AND PROPORTIONATE DISTANCE BETWEEN THE MEANDER CORNER ON THE SOUTH SHORE OF ROUND LAKE TO THE NORTH AND THE SE CORNER OF SECTION 13 TO THE SOUTH.
- M-04 [E1/4 COR SEC 12] NO CORNER EVIDENCE FOUND. REESTABLISHED CORNER POSITION AT THE MIDPOINT BETWEEN AND ON LINE WITH THE SECTION CORNERS 1/2 MILE TO THE NORTH AND SOUTH.

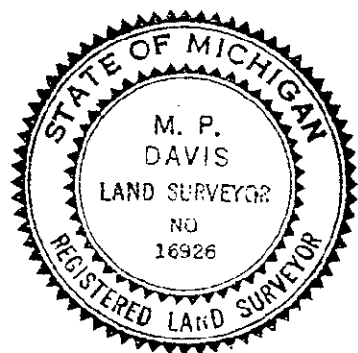

C. Description of monument for corner and accessories established to perpetuate locating the position of the corner:

- M-03 SET A BERNTSEN A1NB30 ALUM MONUMENT WITH THE CAP STAMPED TO ID THE CORNER POSITION.  
CEDAR 12"      HEMLOCK 14"      MAPLE 08"      W. PINE 20"      SURVEY MONUMENT SIGN POST  
N44°W      N63°E      S51°E      S69°W      SOUTH  
42.75'      4.12'      9.64'      13.37'      2.02' (TO FACE)
- M-04 SET A BERNTSEN A1NB30 ALUM MONUMENT WITH THE CAP STAMPED TO ID THE CORNER POSITION.  
W.PINE 14"      W.PINE 13'      W.PINE 12"      W.PINE 14"      SURVEY MONUMENT SIGN POST  
N35°W      N45°E      S68°E      S57°W      NORTH  
28.33'      6.83'      11.79'      9.40'      0.86' (TO FACE)

NOTE: BEARINGS TO REFERENCE OBJECTS ARE MAGNETIC-DISTANCES ARE TO A NAIL W/A DELTA COUNTY REFERENCE TAG, UNLESS OTHERWISE NOTED.

Signed by M.P. Davis Date 12/20/99  
Surveyor's Michigan License No. 16926