

JAN 23 2000

Approved By Delta County
Land Survey Remonumentation

Peer Group Under Act 345 Of
P.A. Of 1990 On Dec 28, 1999

Robert E. Schmeling
Chairman

SECTION

LAND CORNER RECORDATION CERTIFICATE
Filing Requirement of Act 74, Mich. P.A. 1970

For corners in

<u>DELTA</u> (County)	Located In:	Corner Code #
1. Public Land Survey	T 43 N R 20 W	M-1 SAME
	T 44 N R 20 W	M-13
	T 43 N R 19 W	A-1 CORNER
	T 44 N R 19 W	A-13
2. Property Controlling in Section	S ___ T ___ R ___	___
	S ___ T ___ R ___	___
3. Miscellaneous Property in Sec.	S ___ T ___ R ___	___
	S ___ T ___ R ___	___

01-04-00
2:00 PM
PAGE 197
Walter C. Thorne

Register of Deeds Stamp & File Number

4. Lot No. _____, Recorded Plat _____
5. Private Claims _____

I, M.P. DAVIS, in a field survey on NOVEMBER, 19 99 do hereby state that under requirements of P.A. 74, Michigan P.A. of 1970, the corner points mentioned in lines 1 and 2 above were in conformance with regulations and rules therefore as required in the current manual of survey instructions of the United States Department of the Interior, Bureau of Land Management or by a decree of a Court of Law and for that the corner points mentioned in lines 3, 4 and 5 above were in conformance with the rules of the Michigan Board of Land Surveyors or by a Decree of a Court of Law; established, re-established, monumented, recovered, found as expressed below:

A	B	C	D	E	F	G	H	I	J	K	L	M
1												
2	6		5		4		3		2		1	
3												
4	7		8		9		10		11		12	
5												
6	18		17		16		15		14		13	
7												
8	19		20		21		22		23		24	
9												
10	30		29		28		27		26		25	
11												
12	31		32		33		34		35		36	
13												


NOTE: Not more than 2 corners, all in the same town and range, may be recorded on this certificate.

A. Description of original monument and accessories and/or subsequent restoration:

M-1 [NE COR SEC 1] Wm. BURT, D.S.-1841-WOOD POST (HEMLOCK 18" N79°E 54 LINKS)(HEMLOCK 18" S60°W 45 LINKS) ROBERT E. SCHMELING-ESCANABA PAPER CO.-1955-L.3 OF LCR'S PG. 7-FOUND 3/4" IRON PIN IN PLACE. ID CORNER MONUMENT FROM REMAINS OF "GLO" SW BT-SET 1-1/4" I.P. W/A 3" BRASS CAP STAMPED TO ID THE CORNER POSITION [HEMLOCK 11" S44°E 29.5 LINKS][HEMLOCK 11" N42°E 44 LINKS][H.MAPLE 14" N80°W 53 LINKS][HEMLOCK 10" S60°W 69 LINKS]

B. Description of corner evidence found and/or method applied in restoring or reestablishing corner:

M-1 [NE COR SEC 1] FOUND IN PLACE A 1-1/2" I. P. - ID CORNER MONUMENT FROM SCHMELING'S NE AND SE BTS WHICH ARE STILL GREEN WITH THE FACE BLAZES OVERGROWN. ACCEPTED EXISTING MONUMENT AS BEING A CAREFUL AND FAITHFUL PERPETUATION OF THE POSITION OF THE ORIGINAL CORNER.

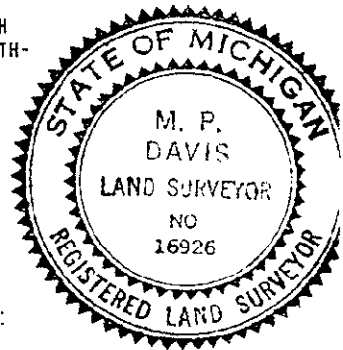

C. Description of monument for corner and accessories established to perpetuate locating the position of the corner:

L-5 DID NOT DISTURB EXISTING MONUMENT				
HEMLOCK 17"(OLD BT)	MAPLE 14"	HEMLOCK 18"(OLD BT)	MAPLE 12"	SURVEY MONUMENT SIGN POST
N52°E	S30°W	S39°E	N80°W	SOUTH
28.87'	30.00'	19.25'	24.92'	1.00'(TO FACE)

NOTE: BEARINGS TO REFERENCE OBJECTS ARE MAGNETIC-DISTANCES ARE TO A NAIL W/A DELTA COUNTY REFERENCE TAG, UNLESS OTHERWISE NOTED.

Signed by M.P. Davis
Surveyor's Michigan License No. 16926

Date 12/20/99