

JAN 25 2000

SECTION

Approved By Delta County  
Land Survey Remonumentation  
Peer Group Under Act 345 Of  
P.A. Of 1990 On Nov 28, 1999

*Charles Schmalz*  
Acting Chairman

LAND CORNER RECORDATION CERTIFICATE  
Filing Requirement of Act 74, Mich. P.A. 1970

For corners in

<u>DELTA</u> (County)	Located In:	Corner Code #
1. Public Land Survey	T <u>43</u> NR <u>20</u> W	M-05 SAME
	T <u>43</u> NR <u>19</u> W	A-05 CORNER
	T <u>43</u> NR <u>20</u> W	M-06 SAME
	T <u>43</u> NR <u>19</u> W	A-06 CORNER
2. Property Controlling in Section	S _____ T _____ R _____	_____
	S _____ T _____ R _____	_____
3. Miscellaneous Property in Sec.	S _____ T _____ R _____	_____
	S _____ T _____ R _____	_____

01-04-00  
AT 2:00 O'CLOCK PM  
BOOK 9 PAGE 116  
*William C. Flinn*  
REGISTERED LAND SURVEYOR

Register of Deeds Stamp & File Number

M-05 [NE COR SEC 13] M-06 [E1/4 COR SEC 13]

4. Lot No. \_\_\_\_\_, Recorded Plat \_\_\_\_\_  
5. Private Claims \_\_\_\_\_

I, M. P. DAVIS, in a field survey on DECEMBER, 1999 do hereby state that under requirements of P.A. 74, Michigan P.A. of 1970, the corner points mentioned in lines 1 and 2 above were in conformance with regulations and rules therefore as required in the current manual of survey instructions of the United States Department of the Interior, Bureau of Land Management or by a decree of a Court of Law and /or that the corner points mentioned in lines 3, 4 and 5 above were in conformance with the rules of the Michigan Board of Land Surveyors or by a Decree of a Court of Law; established, re-established, monumented, recovered, found as expressed below:

NOTE: Not more than 2 corners, all in the same town and range, may be recorded on this certificate.

A	B	C	D	E	F	G	H	I	J	K	L	M
1												
2	6	5	4	3	2	1						
3												
4	7	8	9	10	11	12						
5												
6	18	17	16	15	14	13						
7												
8	19	20	21	22	23	24						
9												
10	30	29	28	27	26	25						
11												
12	31	32	33	34	35	36						
13												

A. Description of original monument and accessories and/or subsequent restoration:


M-05 [NE COR SEC 13] Wm. BURT, D.S.-1841-WOOD POST (SPRUCE 05" N30°E 19 LINKS)(SPRUCE 03" N20°W 20 LINKS)  
A. MERRYWEATHER, D.S.-1849-CORNER IN PLACE (SPRUCE 06" N60°E 53 LINKS)(SPRUCE 04" S45°E 50 LINKS)  
NO RECORD EVIDENCE OF CORNER RECOVERY AND/OR SUBSEQUENT MONUMENTATION.

M-06 [E1/4 COR SEC 13] Wm BURT, D.S. 1841-WOOD POST (SPRUCE 03" N50°E 33 LINKS)(SPRUCE 03" N20°W 20 LINKS)  
NO RECORD EVIDENCE OF CORNER RECOVERY AND/OR SUBSEQUENT MONUMENTATION.

B. Description of corner evidence found and/or method applied in restoring or reestablishing corner:

M-05 [NE COR SEC 13] NO CORNER EVIDENCE FOUND - REESTABLISHED CORNER POSITION ON LINE WITH AND PROPORTIONATE DISTANCE BETWEEN THE MEANDER CORNER ON THE SOUTH SHORE OF ROUND LAKE TO THE NORTH AND THE SE CORNER OF SECTION 13 TO THE SOUTH.

M-06 [E1/4 COR SEC 13] NO CORNER EVIDENCE FOUND. REESTABLISHED CORNER POSITION AT THE MIDPOINT BETWEEN AND ON LINE WITH THE SECTION CORNERS 1/2 MILE TO THE NORTH AND SOUTH.

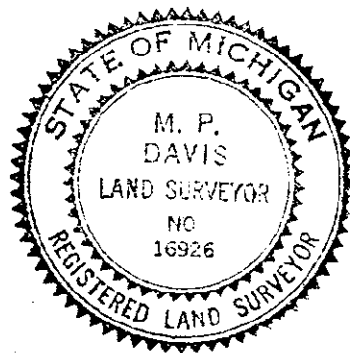

C. Description of monument for corner and accessories established to perpetuate locating the position of the corner:

M-05	SET A BERNTSEN A1NB30 ALUM MONUMENT WITH THE CAP STAMPED TO ID THE CORNER POSITION.
	TAMARACK 03" TAMARACK 04" TAMARACK 03" SURVEY MONUMENT SIGN POST
	N48°E S21°W S88°W NORTH
	13.85' 45.75' 17.12' 1.45'(TO FACE)

M-06	SET A BERNTSEN A1NB30 ALUM MONUMENT WITH THE CAP STAMPED TO ID THE CORNER POSITION.
	TAMARACK 03" SPRUCE 13" TAMARACK 03" SPRUCE 04" SURVEY MONUMENT SIGN POST
	N79°W NORTH S65°E S13°W SOUTH
	8.20' 18.40' 19.28' 24.75' 0.68'(TO FACE)

NOTE: BEARINGS TO REFERENCE OBJECTS ARE MAGNETIC-DISTANCES ARE TO A NAIL W/A DELTA COUNTY REFERENCE TAG, UNLESS OTHERWISE NOTED.

Signed by M. P. Davis  
Surveyor's Michigan License No. 16926

Date 12/28/99