

JAN 25 2000

Approved By Delta County
Land Survey Remonumentation
Peer Group Under Act 345 Of
P.A. Of 1990 On Dec 28, 1999

Walter C. Thomas
Chairman

LAND CORNER RECORDATION CERTIFICATE
Filing Requirement of Act 74, Mich. P.A. 1970

SECTION

For corners in

<u>DELTA</u> (County)	Located in:	Corner Code #
1. Public Land Survey	T 43 NR 20 W	MC K/L-1 SAME (3)
	T 44 NR 20 W	MC K/L-13 CORNER
	T 43 NR 20 W	MC L/M-1 SAME (1) ✓
	T 44 NR 20 W	MC L/M-12 CORNER
2. Property Controlling in Section	S ___ T ___ R ___	_____
	S ___ T ___ R ___	_____
3. Miscellaneous Property in Sec.	S ___ T ___ R ___	_____
	S ___ T ___ R ___	_____

01-04-00
2:00 O'CLOCK PM
9 PAGE 193
Walter C. Thomas
Register of Deeds Stamp & File Number

K/L-1 [MC N LINE SEC 1 W. SHORE ROUND LAKE] L/M-1 [MC N. LINE SEC 1 E. SHORE ROUND LAKE]

4. Lot No. _____, Recorded Plat _____
5. Private Claims _____

I, M.P. DAVIS, in a field survey on DECEMBER, 19 99 do hereby state that under requirements of P.A. 74, Michigan P.A. of 1970, the corner points mentioned in lines 1 and 2 above were in conformance with regulations and rules therefore as required in the current manual of survey instructions of the United States Department of the Interior, Bureau of Land Management or by a decree of a Court of Law and /or that the corner points mentioned in lines 3, 4 and 5 above were in conformance with the rules of the Michigan Board of Land Surveyors or by a Decree of a Court of Law; established, re-established, monumented, recovered, found as expressed below:

NOTE: Not more than 2 corners, all in the same town and range, may be recorded on this certificate.


A	B	C	D	E	F	G	H	I	J	K	L	M
1												
2	6		5		4		3		2		1	
3												
4	7		8		9		10		11		12	
5												
6	18		17		16		15		14		13	
7												
8	19		20		21		22		23		24	
9												
10	30		29		28		27		26		25	
11												
12	31		32		33		34		35		36	
13												

A. Description of original monument and accessories and/or subsequent restoration:

- K/L-1 [MC N. LINE SEC 1- WEST SHORE ROUND LAKE] A.MERRYWEATHER, D.S.-1848-WOOD POST (HEMLOCK 16" S61°W 47 LINKS)(TAMARACK 12" N40°W 26 LINKS)
BAY DE NOC LUMBER COMPANY'S UNRECORDED PLAT OF GOV. LOT 5 OF ROUND LAKE SHOWS CORNER IN PLACE-NO DESCRIPTION GIVEN.
- L/M-1 [MC N. LINE SEC 1- EAST SHORE ROUND LAKE] A.MERRYWEATHER, D.S.-1849-WOOD POST (CEDAR 10" S60°E 65 LINKS)(TAMARACK 07" N10°E 87 LINKS)
BAY DE NOC LUMBER COMPANY'S UNRECORDED PLAT OF GOV. LOT 6 OF ROUND LAKE SHOWS CORNER IN PLACE-NO DESCRIPTION GIVEN.

B. Description of corner evidence found and/or method applied in restoring or reestablishing corner:

- K/L-1 [MC N. LINE SEC.1- WEST SHORE ROUND LAKE] FOUND IN PLACE A 5/8" IRON PIPE AND THE REMAINS OF A 2" X 4" WOOD POST MARKED "1" WHICH CORRESPONDS TO THE LOT NUMBER AT THIS LOCATION OF BAY DE NOC LUMBER COMPANY'S UNRECORDED PLAT OF GOV. LOT 5 OF ROUND LAKE. ACCEPTED EXISTING MONUMENT AS BEING THE BEST AVAILABLE EVIDENCE AS TO THE LOCATION OF THE POSITION OF THE ORIGINAL CORNER.
- L/M-1 [MC N. LINE SEC.1-EAST SHORE ROUND LAKE] FOUND IN PLACE A 1/2" REBAR ENCASED IN A 4" X 4" CONCRETE MONUMENT. ID CORNER MONUMENT FROM RETRACEMENT OF THE NORTH LINE OF BAY DE NOC LUMBER COMPANY'S UNRECORDED PLAT OF GOVERNMENT LOT 6 OF ROUND LAKE. ACCEPTED EXISTING MONUMENT AS BEING THE BEST AVAILABLE EVIDENCE AS TO THE LOCATION OF THE POSITION OF THE ORIGINAL CORNER.

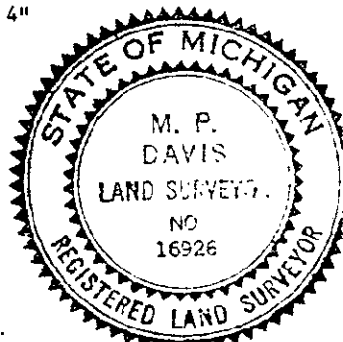

C. Description of monument for corner and accessories established to perpetuate locating the position of the corner:

- K/L-1 SET, OVER EXISTING MONUMENT, A BERNTSEN A1NB30 ALUM MONUMENT WITH THE CAP STAMPED TO ID THE CORNER POSITION.
W. PINE 16" HEMLOCK 18" TAMARACK 07" SURVEY MONUMENT SIGN POST
S819W N67°W S43°E EASTE
23.81' 28.42' 63.73' 0.79' (TO FACE)
- L/M-1 SET, ALONG EAST SIDE OF EXISTING MONUMENT, A BERNTSEN A1NB30 ALUM MONUMENT WITH THE CAP STAMPED TO ID THE CORNER POSITION.
W.PINE 22" TAMARACK 10" MAPLE 18" SURVEY MONUMENT SIGN POST
N27°E S32°E N66°E WEST
61.82' 60.00' 30.30' 1.18' (TO FACE)

NOTE: BEARINGS TO REFERENCE OBJECTS ARE MAGNETIC-DISTANCES ARE TO A NAIL W/A DELTA COUNTY REFERENCE TAG, UNLESS OTHERWISE NOTED.

Signed by M.P. Davis
Surveyor's Michigan License No. 16926

Date 12/20/99