

COMMAD TO T39N 28W
A-4 ✓

RECORDED

LAND CORNER RECORDATION CERTIFICATE
Filing Requirement of Act 74, Mich. P.A. 1970

1998 JUN 12 AM 8:59

For corners in

Dickinson
(County)
Norway Twp.

Located In:

Corner Code #

1. Public Land Survey

T 39NR 29W

K-4

T R

M-4

T R

T R

S T R

S T R

S T R

S T R

2. Property Controlling in Section

3. Miscellaneous Property in Sec.

SURVEY & REMONUMENTATION

NOV 15 1999

SECTION

REGISTER OF DEEDS
DICKINSON COUNTY
IRON MOUNTAIN, MICHIGAN

Register of Deeds Stamp & File Number

4. Lot No. _____, Recorded Plat _____
5. Private Claims _____

	A	B	C	D	E	F	G	H	I	J	K	L	M
1													
2	6		5		4		3		2		1		
3													
4	7		8		9		10		11		12		
5													
6	18		17		16		15		14		13		
7													
8	19		20		21		22		23		24		
9													
10	30		29		28		27		26		25		
11													
12	31		32		33		34		35		36		
13													

I, Robert F. Perkins, in a field survey on Mar. 19, 1998 do hereby state that under requirements of P.A. 74, Michigan P.A. of 1970, the corner points mentioned in lines 1 and 2 above were in conformance with regulations and rules therefore as required in the current manual of survey instructions of the United States Department of the Interior, Bureau of Land Management or by a decree of a Court of Law and/or that the corner points mentioned in lines 3, 4 and 5 above were in conformance with the rules of the Michigan Board of Land Surveyors or by a Decree of a Court of Law, established, re-established, monumented, recovered, found as expressed below:

NOTE: Not more than 2 corners, all in the same town and range, may be shown on this certificate.

REGISTERED WITH THE DICKINSON COUNTY SURVEY PEER GROUP AS THE OFFICIAL CORNER UNDER MICHIGAN PUBLIC ACT 345 OF 1990 AT A MEETING HELD ON 6-4-98
RFP

A. Description of original monument and accessories and/or subsequent restoration:

K-4 1/4 Corner, 11/12
James H. Mullett, D.S. 1849
40.00 Set 1/4 Post
Original Bearing Trees
Hemlock 12" S30°E 22 L.
Hemlock 6" N65°W 17 L.
Corner Researched in 1994

M-4 East 1/4 Corner, Section 12
James H. Mullett, D.S. 1849
40.00 Set 1/4 Post
Original Bearing Trees
Maple 10" S30°W 20 L.
Fir 6" N80°W 15 L.
V5°50'E
Corner Researched in 1993

B. Description of corner evidence found and/or method applied in restoring or reestablishing corner:

4 No evidence of Original Corner or Accessories Found.
Established Corner by Single Proportionate Method on Line with Section Corners 1/2 Mile North and 1/2 Mile South. Found remains of Barbed Wire Fence running South.

M-4 No evidence of Original Corner or Accessories Found.
Found 1" Drill Steel in Concrete projecting 12". Also Oak B.T. by B.Buckler RLS (old Report #615, 2-21-1961).
Distance checks South to 1/16 Corner and Section Corner. Monument resembles type set by Mining Co., circa 1900.


Description of monument for corner and accessories established to perpetuate locating the position of the corner:

Set 2 1/2" Stamped D.C. Remon. Corner.
New Witnesses:
Hemlock 12" N85°W (M.B.) 35.76' Nail/Tag
Maple 6" N77°E (M.B.) 10.55' Nail/Tag
Maple 4" S27°E (M.B.) 1.40' Nail/Tag
Dbl. Maple 6" S48°W (M.B.) 17.70' Nail/Tag
Placed Carsonite Marker North 1.0'

M-4 Accepted above monument as best remaining Evidence of Corner Location.
Stamped Existing Iron 12/7
New Witnesses:
Oak 22" N30°W (M.B.) 59.90' (Old B.T.)
W.Pine 10" S61°E (M.B.) 43.93' Nail/Tag
Hemlock 10" N45°W (M.B.) 10.83' Nail/Tag
Oak 5" S15°W (M.B.) 26.29' Nail/Tag
Carsonite Marker North 1.4'

Surveyed by Robert F. Perkins
Surveyor's Michigan License No. 12027

Date June 15, 1998

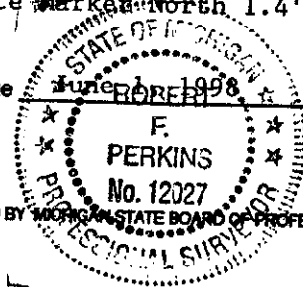

LICED PAGE 360